

MONTANA
DEPARTMENT OF TRANSPORTATION

AS-BUILTS

BRIDGE PLANS AND QUANTITIES

FEDERAL AID PROJECT NO. NH-IM 0002(270) P.E.
NHTSA 0002(393) CONSTRUCTION

D4-NON-INTERSTATE GUARDRAIL

VALLEY, ROOSEVELT, RICHLAND, CUSTER, GARFIELD, McCONE AND PHILLIPS COUNTIES

LIST OF DRAWINGS

<u>SHEET NO.</u>	<u>DWG. NO.</u>	<u>TITLE</u>
B2	18743 Q2	QUANTITY SUMMARY
B3	18744	BRIDGE RAIL REVISION ON ROUTE N-1 AT RP 508+0.888 AND RP 514+0.737
B4	18745	BRIDGE RAIL REVISION ON ROUTE N-1 AT RP 514+0.943
B5	18746	BRIDGE APPROACH SECTIONS ON ROUTES N-20, N-22 AND N-57
B6	18747	BARRIER END MODIFICATION ON ROUTE N-20 AT RP 37+0.515
B7	18748	BRIDGE APPROACH SECTIONS ON ROUTE N-23 AT RP 15+0.943
B8	18749	BRIDGE RAIL REVISION ON ROUTE N-57 AT RP 231+0.023 AND RP 232+0.710
B9	18750	BRIDGE RAIL REVISION ON ROUTES N-1, N-57 AND N-61
B10	18751	BRIDGE RAIL REVISION ON ROUTE N-57 AT RP 239+0.257
B11	18752	DRILLED SHAFT ANCHOR POST
B12	18753	SWAY BRACING DETAILS ON ROUTE N-57 AT RP 232+0.710, 247+0.394 AND 255+0.300
B13	7020	EXISTING GENERAL LAYOUT ON ROUTE N-1 RP 508+0.888
B14	7026	EXISTING GENERAL LAYOUT ON ROUTE N-1 RP 514+0.737
B15	7032	EXISTING GENERAL LAYOUT ON ROUTE N-1 RP 514+0.943
B16	3700	EXISTING GENERAL LAYOUT ON ROUTE N-1 RP 645+0.625
B17	1809	EXISTING GENERAL LAYOUTS ON ROUTE N-57 RP 231+0.023 AND RP 232+0.710
B18	2057	EXISTING GENERAL LAYOUTS ON ROUTE N-57 RP 232+0.566 AND RP 235+0.652
B19	2176	EXISTING GENERAL LAYOUT ON ROUTE N-57 RP 234+0.523
B20	1810	EXISTING GENERAL LAYOUT ON ROUTE N-57 RP 239+0.257
B21	1949A	EXISTING GENERAL LAYOUT ON ROUTE N-57 RP 247+0.394
B22	1812	EXISTING GENERAL LAYOUT ON ROUTE N-57 RP 248+0.831
B23	1813	EXISTING GENERAL LAYOUTS ON ROUTE N-57 RP 249+0.748 AND RP 253+0.331
B24	1813A	EXISTING GENERAL LAYOUTS ON ROUTE N-57 RP 254+0.769, RP 254+0.838, RP 255+0.300 AND RP 257+0.150
B24A	1814	EXISTING GENERAL LAYOUT ON ROUTE N-57 RP 260+0.150
B25	2280	EXISTING GENERAL LAYOUTS ON ROUTE N-61 RP 133+0.425 AND RP 136+0.511
B26	2177	EXISTING GENERAL LAYOUT ON ROUTE N-61 RP 137+0.076

AS-BUILTS

GENERAL NOTES

GENERAL: Plans were prepared from original drawings and as-built drawings. No additional survey information was procured for this project. Existing structure dimensions may vary from those shown on the drawings. Verify all dimensions necessary to complete the work.

SPECIFICATIONS: Montana Department of Transportation and the Montana Transportation Commission Standard Specifications for Road and Bridge Construction, 1995 edition, and any amendments thereto, and the Special Provisions govern unless otherwise noted. Design was prepared in accordance with AASHTO Standard Specifications for Highway Bridges, 17th Edition - 2002, and any amendments thereto.

REINFORCING STEEL: Use new deformed type reinforcing steel meeting the requirements of AASHTO M 31M Grade 60 (420).

Replace existing reinforcing steel damaged during construction that is called out to remain in place at no additional cost to the State.

Include cleaning exposed existing reinforcing steel in other items of work.

GALVANIZING: Galvanize all bolts, nuts and washers in accordance with AASHTO M 232M. Galvanize metal guardrail in accordance with ASTM Specification A 653M or AASHTO M 111M.

EPOXY RESIN BONDING AGENT: Thoroughly coat all existing concrete in contact with new concrete with an epoxy bonding agent (AASHTO M 235-91 Type V) immediately prior to placing new concrete. Include all costs associated with providing and applying the epoxy bonding agent in the other items.

TRAFFIC CONTROL PLAN AND SEQUENCE OF OPERATION: See Special Provisions.

DIMENSIONS: All dimensions are in millimeters except as noted. Verify all necessary dimensions of the existing structures in the field before ordering materials. Obtain approval of shop plans from the State of Montana, Department of Transportation before beginning fabrication. If the dimensions and details of the existing structure are not as shown on the plans, vary construction as necessary to best suit existing conditions and the nature of the intended work.

D4-NON-INTERSTATE GUARDRAIL

FEDERAL AID PROJECT NO. NHTSA 0002 (393)

FEDERAL AID PROJECT NO. NHT

VARIOUS COUNTIES

QUANTITY SUMMARY

6-11-03 L. M. S.
6-11-03 L. M. S.
6-26-03 D. J. R.

REVISED

ESTIMATED BRIDGE PLAN QUANTITIES									
ROUTE	REFERENCE POST	BRIDGE ID NUMBER	FEATURE CROSSED	REVISE BRIDGE RAIL - THRIE BEAM (m)	REVISE BRIDGE RAIL - CONCRETE BARRIER (m)	REVISE TIMBER BRIDGE RAIL - T101 (m)	ANCHOR POST (EACH)	TREATED TIMBER m³	<i>SPLIT</i>
N-1	508+0.888	P00001508+0888	BEAVER CREEK	107.62					<i>7</i>
N-1	514+0.737	P00001514+0737	MILK RIVER	218.17					<i>8</i>
N-1	514+0.943	P00001514+0943	MILK RIVER OVERFLOW		89.27				<i>9</i>
N-1	645+0.625	P00001645+0625	SHEEP CREEK			42.54 42.544	4		<i>10</i>
N-57	231+0.023	P00057231+0023	DRAINAGE			42.54 42.544	4		<i>11</i>
N-57	232+0.566	P00057232+0566	DRAINAGE			22.22 22.224	4		<i>12</i>
N-57	232+0.710	P00057232+0710	DRAINAGE			52.70 52.704	4	0.79 0.777	<i>13</i>
N-57	234+0.523	P00057234+0523	DRAINAGE			67.94 67.944	4		<i>14</i>
N-57	235+0.652	P00057235+0652	DRAINAGE			62.86 62.864	4		<i>15</i>
N-57	239+0.257	P00057239+0257	LITTLE DRY CREEK			253.36 253.364	4		<i>16</i>
N-57	247+0.394	P00057247+0394	DRAINAGE			67.94 67.944	4	0.14 0.292	<i>17</i>
N-57	248+0.831	P00057248+0831	TIMBER CREEK			83.18 83.184	4		<i>18</i>
N-57	249+0.748	P00057249+0748	SKULL CREEK			80.64 80.644	4		<i>19</i>
N-57	253+0.331	P00057253+0331	DRAINAGE			57.78 57.784	4		<i>20</i>
N-57	254+0.769	P00057254+0769	DRAINAGE			57.78 57.784	4		<i>21</i>
N-57	254+0.838	P00057254+0838	DRAINAGE			52.70 52.704	4		<i>22</i>
N-57	255+0.300	P00057255+0300	DRAINAGE			62.86 62.864	4	1.51 1.504	<i>23</i>
N-57	257+0.150	P00057257+0150	COULEE			52.70 52.704	4		<i>24</i>
N-57	260+0.150	P00057260+0150	STOCKPASS			17.14 17.144	4		<i>25</i>
N-61	133+0.425	P00061133+0425	BIG WARM SPRING CREEK			67.94 67.944	4		<i>26</i>
N-61	136+0.511	P00061136+0511	WILD HORSE CR OVERFLOW			42.54 42.544	4		<i>27</i>
N-61	137+0.076	P00061137+0076	WILD HORSE CREEK			67.94 120.648	4 8		<i>28</i>
TOTAL				325.79	89.27	1255.30 1308.08	76 80	2.44 2.573	


Misty Miner
22-10-2005

Metal Guardrail - Bridge Approach Section Type 3
(See Det. Dwg. No. 606-24, 606-25 and Road Plans)
Warp new guardrail down gradually to conform
with normal height of Road Guardrail

Included in the unit price bid for Revise Bridge Rail - Thrie Beam
(See summary table for payment lengths)

Metal Guardrail - Bridge Approach Section Type 3
(See Det. Dwg. No. 606-24, 606-25 and Road Plans)
Warp new guardrail down gradually to conform
with normal height of Road Guardrail

NOTE: Make bridge approach section
continuous with existing bridge rail.

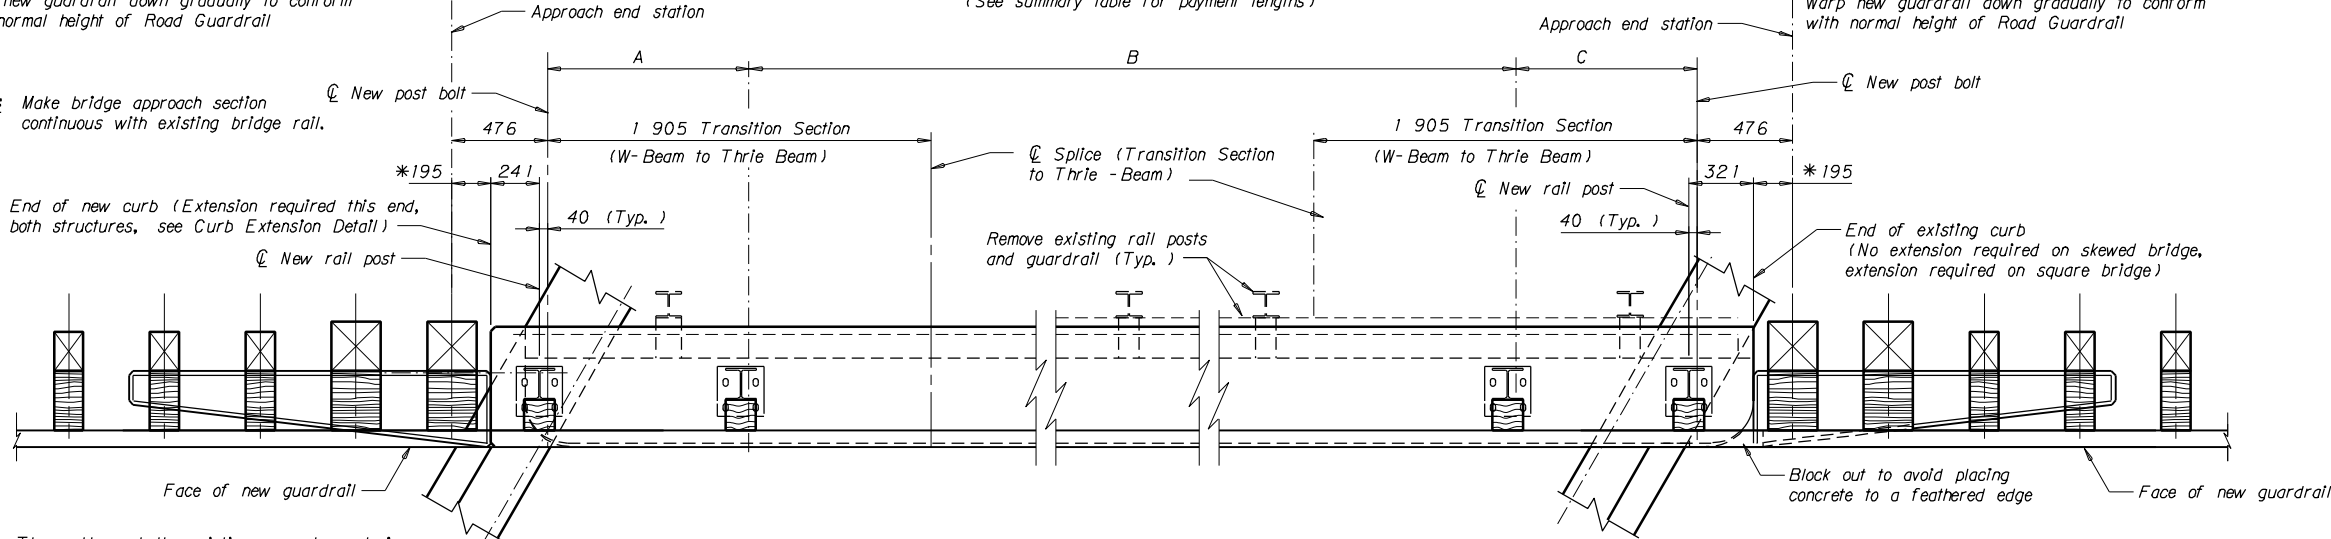


NOTE: Thoroughly coat the existing concrete curb in
contact with new concrete with an epoxy bonding
agent (AASHTO M 235-91 Type V)
Immediately prior to placing new concrete.

Drill 18 mm Ø holes in blockout
and post after transition section
has been erected

PARTIAL PLAN VIEW

NOTE: Plug predrilled holes in rail with
standard splice bolts. See Detailed
Dwg. No. 606-82.

* NOTE: The 195 mm dimension is required with wood posts.
The contractor has the option to use steel posts.
See Detailed Drawings for dimensions.

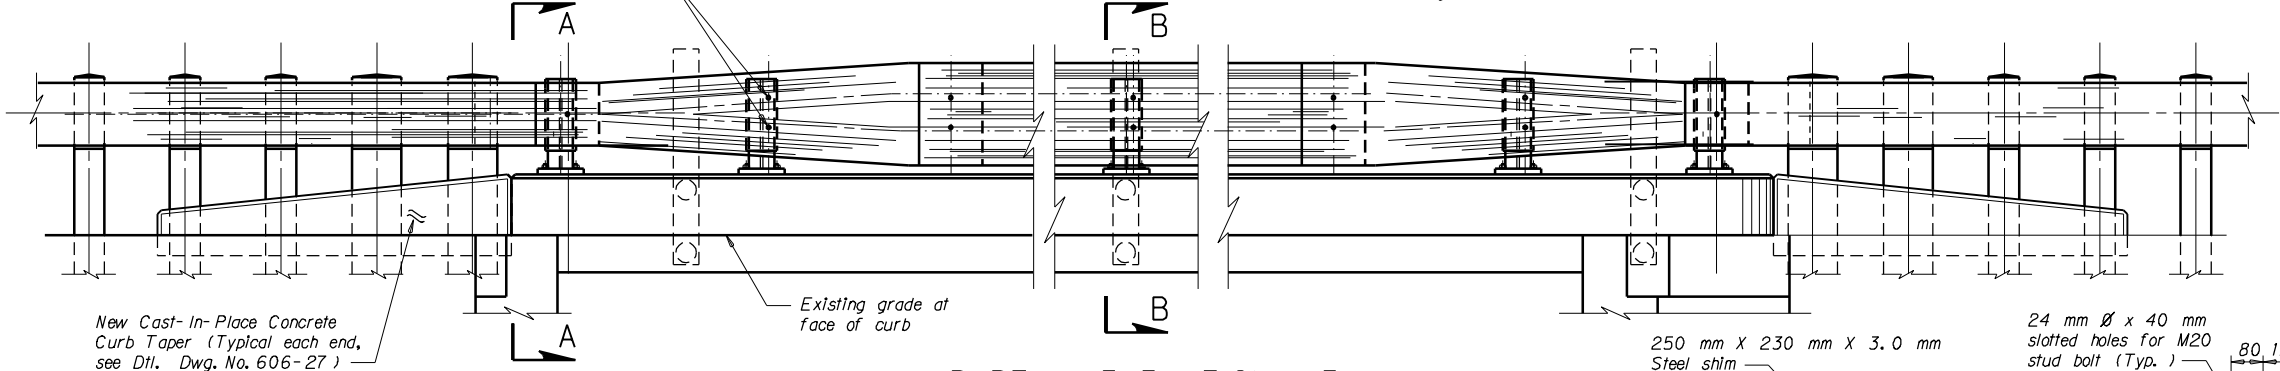

PARTIAL ELEVATION VIEW

RAIL REVISION SUMMARY TABLE <i>(Details shown apply to both sides of the structure)</i>										
STRUCTURE LOCATION		GENERAL LAYOUT DWG. NO.	SKEW	DIMENSIONS			LENGTH OF RAIL (ONE SIDE ONLY) (m)	TOTAL LENGTH FOR PAYMENT (m)	APPROACH END STATIONING	
				A	B	C			BENT NO. 1	BENT NO. 3 or 5
Route N- 1	508+0.888	7020	30°	1 028	20 Spa. @ 2 540 = 50 800	1 028	53.808	107.616	10+45.72 Rt. 10+45.72 Lt.	9+54.28 Lt. 9+54.28 Rt.
Route N- 1	514+0.737	7026	0°	727	42 Spa. @ 2 540 = 106 680	727	109.086	218.172	10+45.72 Rt. 10+45.72 Lt.	9+61.90 Lt. 9+61.90 Rt.

RAIL POST SHIM DETAIL

Scale ~ 1 : 10

NOTE: Furnish shims as necessary to adjust rail to grade.
Place shims between fiber reinforced pads. Place
shims with slots toward roadway centerline.

BASE PLATE DETAIL

Scale ~ 1 : 10

CURB EXTENSION DETAIL

Scale ~ 1 : 15

2 extensions required on skewed bridge
4 extensions required on square bridge

SECTION A-A

Scale ~ 1 : 10

NOTE: Place blockouts made of treated timber with the
wood grain perpendicular to the bolt centerline.

SECTION B-B

Scale ~ 1 : 10

NOTES

NHTSA 0002(393)

B3

AS-BUILTS


PAINTING: Paint all posts and plates (except as noted) in accordance
with the Standard Specifications. Galvanizing the posts and plates in
accordance with AASHTO M 111M will be allowed.

REFLECTORS: Place a reflector on each end rail post and at approximately
equal spacing (every third rail post but not to exceed 7620 mm) between
end rail posts. Mount reflectors with reflectorized face toward oncoming traffic.
See Det. Dwg. No. 606-05B for reflector detail.

PAYMENT: Revise Bridge Rail ~ Thrie Beam is paid for by the linear
meter which is full compensation for all resources necessary to complete the
item. The number of linear meters of Revise Bridge Rail ~ Thrie Beam
for payment is shown on the Summary Table on this sheet. Use new posts and
plates conforming to AASHTO M 270M Grade 250T3. Use metal guardrail
conforming to AASHTO M 180 and lap in direction of traffic. Use Thrie
Beam sections meeting the requirements of AASHTO designation Type 1 Class B.
Use 1905 mm transition sections, from standard metal guard rail to thrie beam,
meeting the requirements of AASHTO designation Type 1 Class A.





ERECTION: Set the rail parallel to the roadway grade. Adjust rail to
proper rail height using vertical slots in rail post or rail post shims.

Replace any item which is to be incorporated in the rehabilitated structure that is
damaged during construction at no additional cost to the State.

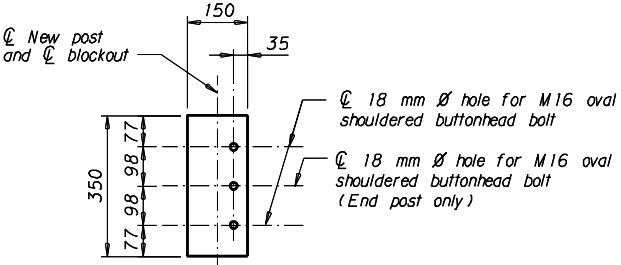

TYPICAL BLOCKOUT ELEVATION

Scale ~ 1 : 10

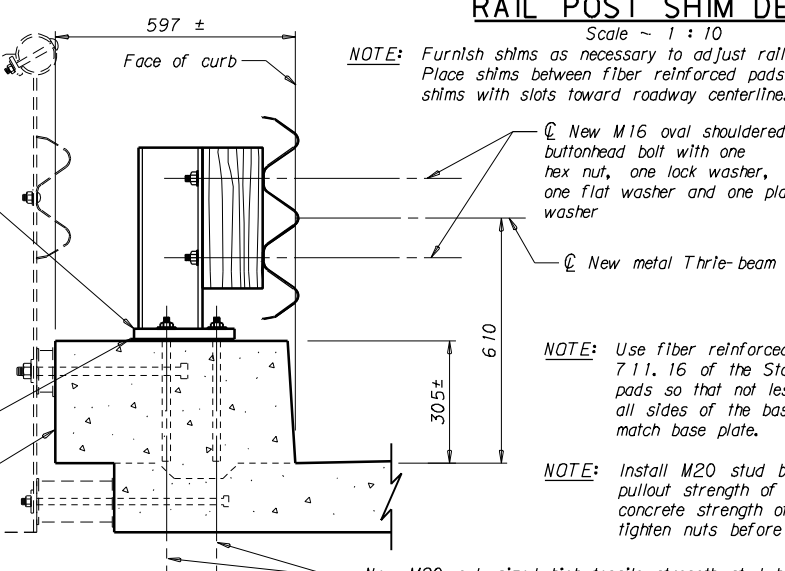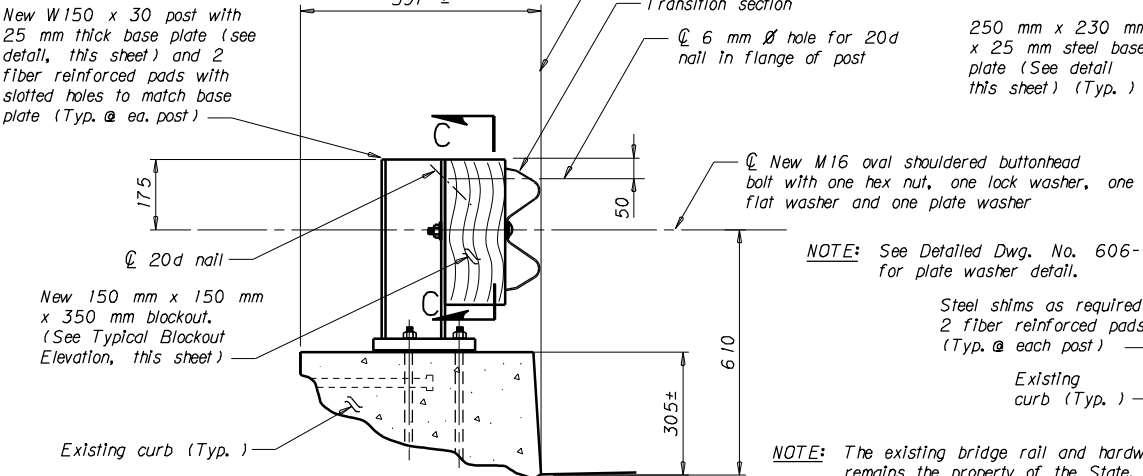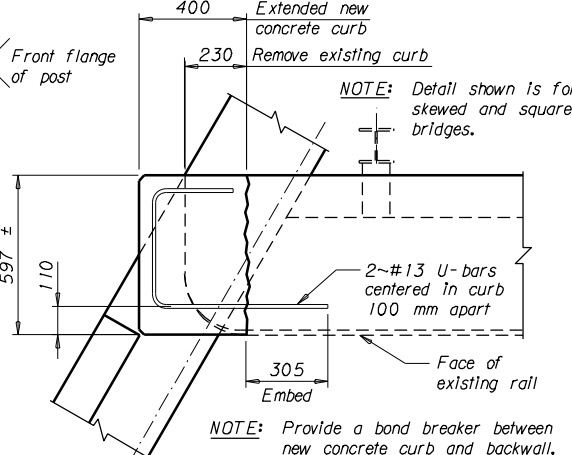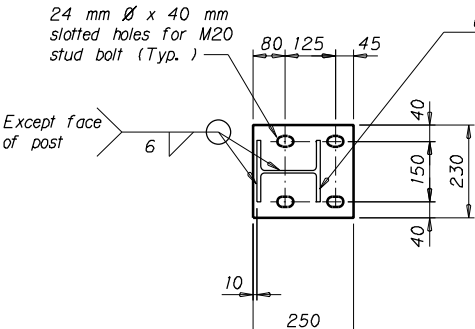

SECTION C-C

Scale ~ 1 : 10

NOTE: Use fiber reinforced pads meeting the requirements of subsection
711.16 of the Standard Specifications. Size and position the
pads so that not less than 10 mm of the pad protrudes on
all sides of the base plate. Punch slotted holes in pads to
match base plate.

NOTE: Install M20 stud bolts such that a minimum
pullout strength of 78 kN is achieved assuming a
concrete strength of f'c of 21 MPa. Do not
tighten nuts before achieving full required strength.

D4-NON-INTERSTATE GUARDRAIL
ON ROUTE N-1 AT RP 508+0.888 & 514+0.737
FEDERAL AID PROJECT NO. NHTSA 0002(393)

VALLEY COUNTY


BRIDGE RAIL REVISION

1-29-03 L. M. S.
2-24-03 L. M. S.
6-17-03 D. J. R.


REVISED

Scale ~ 1 : 20 except as noted


Misty Miner
22-10-2005

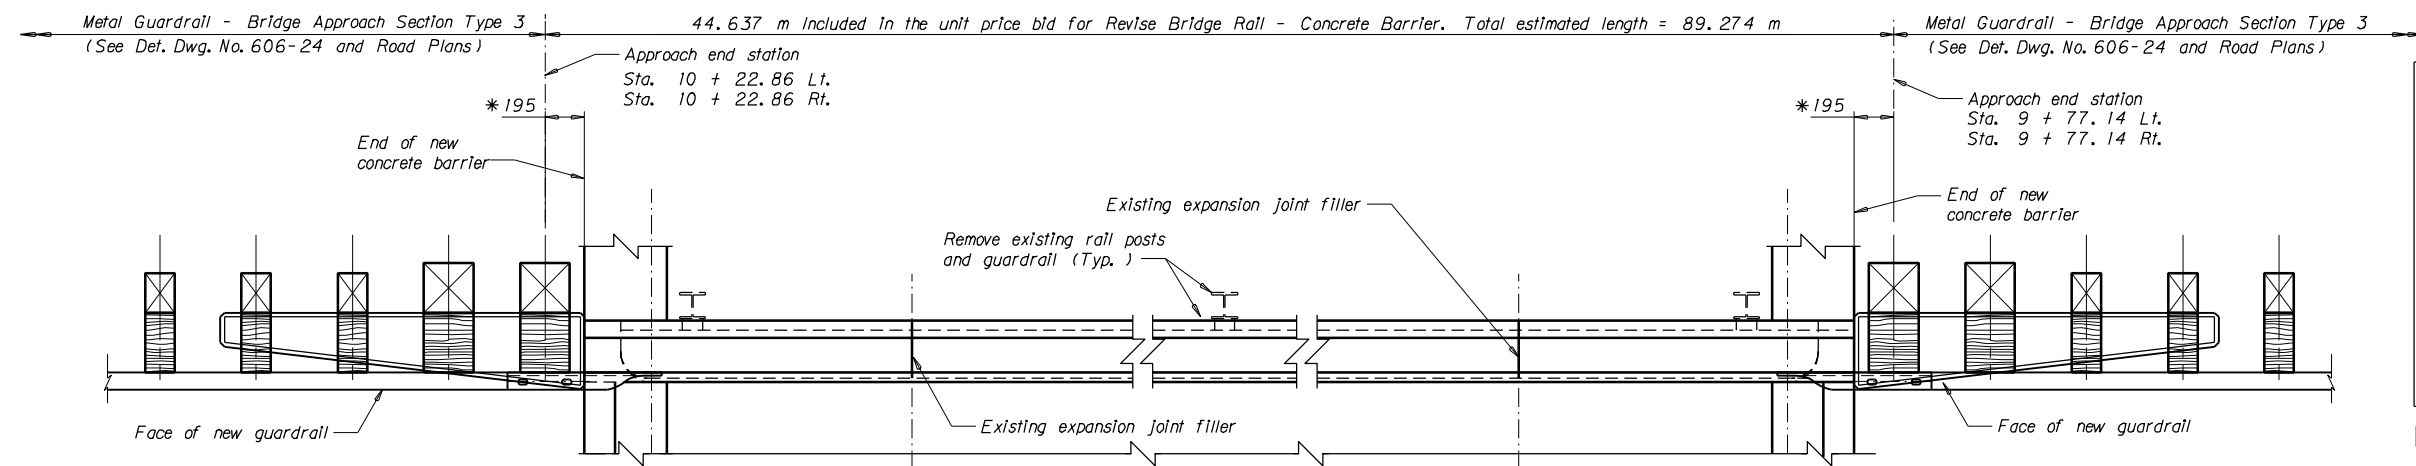

PARTIAL PLAN VIEW

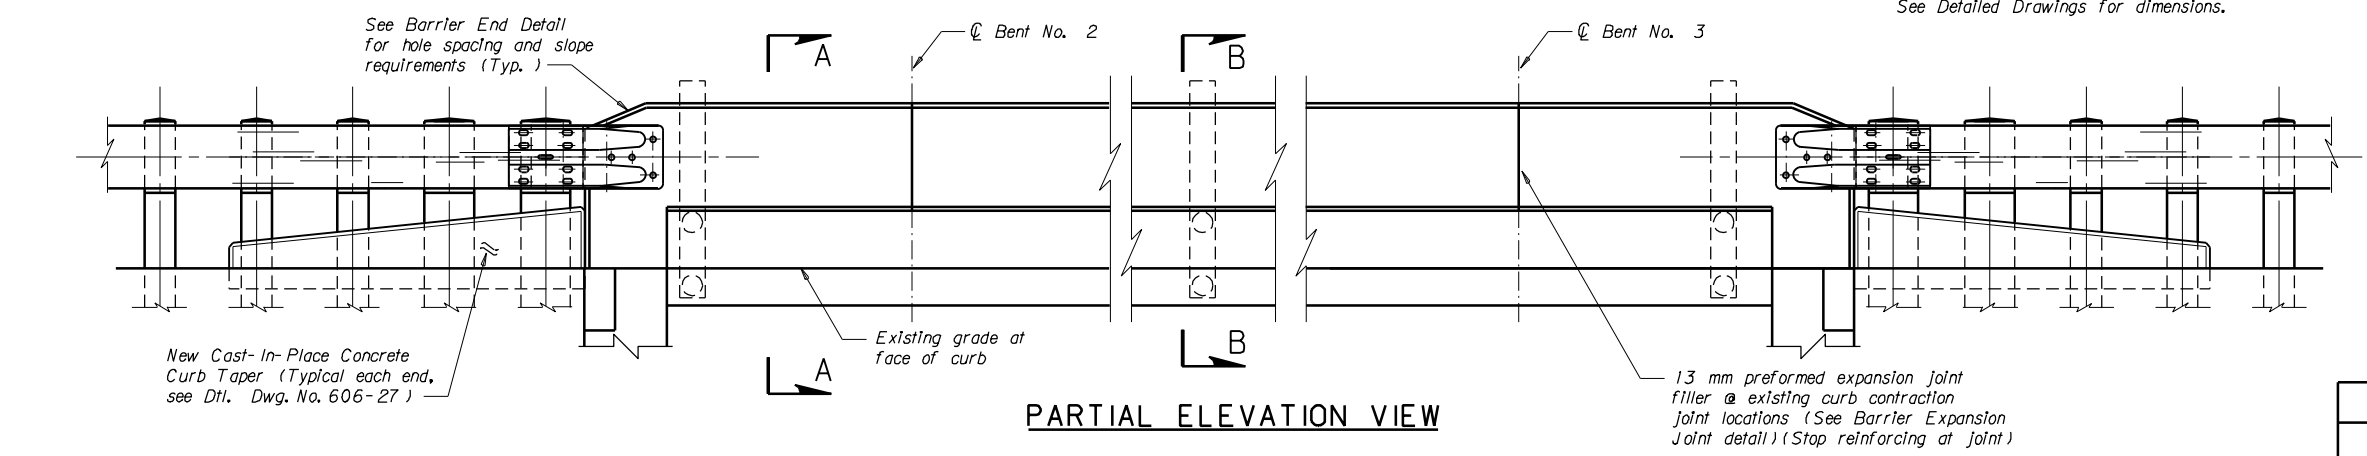


PARTIAL ELEVATION VIEW

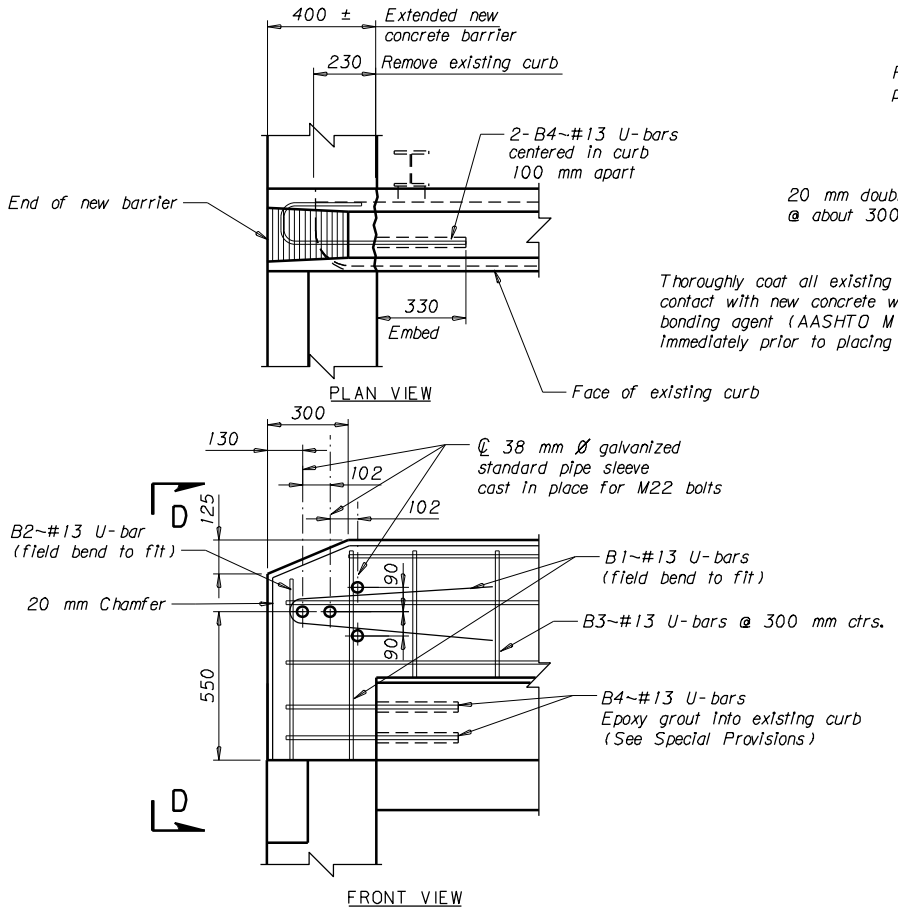


BARRIER END DETAIL

Scale ~ 1 : 15

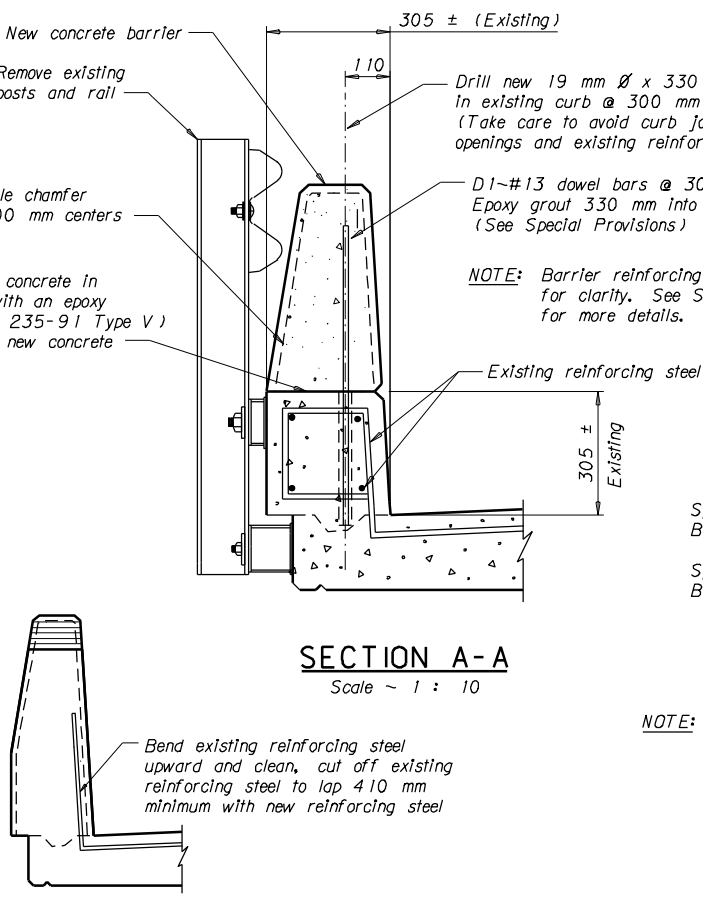


SECTION A-A

Scale ~ 1 : 10

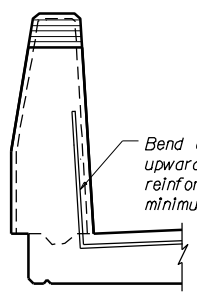

VIEW D-D

Scale ~ 1 : 15

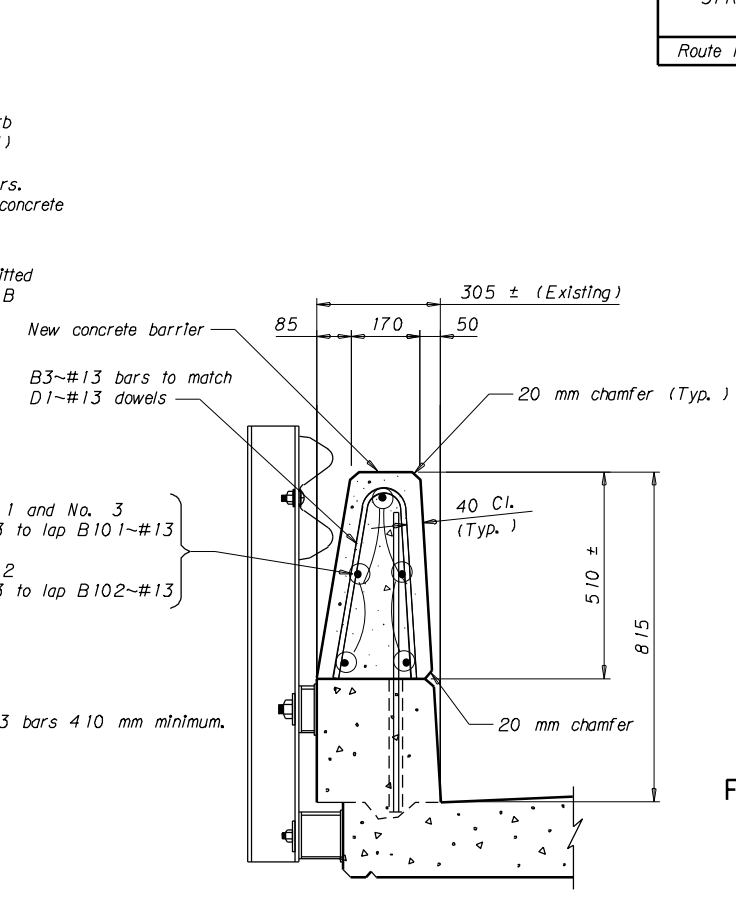

SECTION B-B

Scale ~ 1 : 10

NOTE: Lap #13 bars 410 mm minimum.

AS-BUILTS

NHTSA 0002(393)

B4

BILL OF REINFORCING STEEL (FOR INFORMATION ONLY)												
<p>TYPE 17</p>						<p>TYPE 33</p>						
STRAIGHT BARS				BENT BARS (All dimensions are out to out)								
Mark	Size	No.	Length	Mark	Size	No.	Type	Length	A	B	C	D
B100	#13	30	12 190	B1	#13	8	33	1 590	770	770	230	90
B101	#13	20	2400	B2	#13	4	33	1 400	670	670	230	110
B102	#13	10	3820	B3	#13	294	33	1 010	480	480	205	90
				B4	#13	8	17	1 150		690	160	300
D1	#13	294	740									

NOTES:

REFLECTORS: Place a white reflector on top of concrete barrier at 9.15 meter spacing between ends of barrier. Mount reflectors with reflectorized face toward oncoming traffic. See Dtl. Dwg. No. 606-60 for reflector detail.

PAYMENT: With the exception to Bridge Approach Sections, the unit price bid for Revise Bridge Rail - Concrete Barrier includes all resources necessary to complete the item as shown on the plans.

See General Layout Dwg. No. 7032 for more information.


Use Class SD concrete in barriers. Galvanize all new hardware.

Details shown on this drawing apply to both sides for the entire length of the structure.

Replace existing reinforcing steel damaged during construction that is called out to remain in place at no additional cost to the State.

The existing bridge rail and hardware remains the property of the State. Neatly stockpile as indicated by the Engineer.

REVISE BRIDGE RAIL - CONCRETE BARRIER				
STRUCTURE LOCATION		GENERAL LAYOUT NO.	LENGTH OF BARRIER (one side only)	TOTAL LENGTH
Route N-1	514 + 0.943	7032	44.637 m	89.274 m

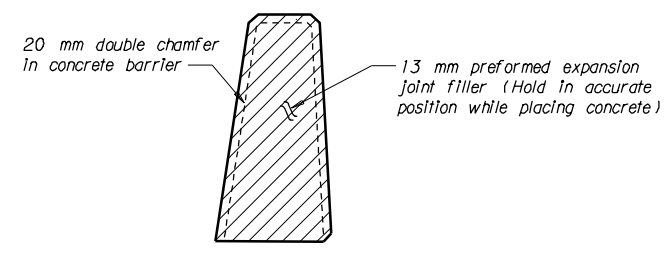

BARRIER EXPANSION JOINT

Scale ~ 1 : 10

D4-NON-INTERSTATE GUARDRAIL
ON ROUTE N-1 AT RP 514+0.943
FEDERAL AID PROJECT NO. NHTSA 0002(393)
VALLEY COUNTY
BRIDGE RAIL REVISION


3-10-03 L. M. S.
3-11-03 L. M. S.
6-18-03 D. J. R.

REVISED

Scale ~ 1 : 20 except as noted


Misty Miner
22-10-2005

AS-BUILT

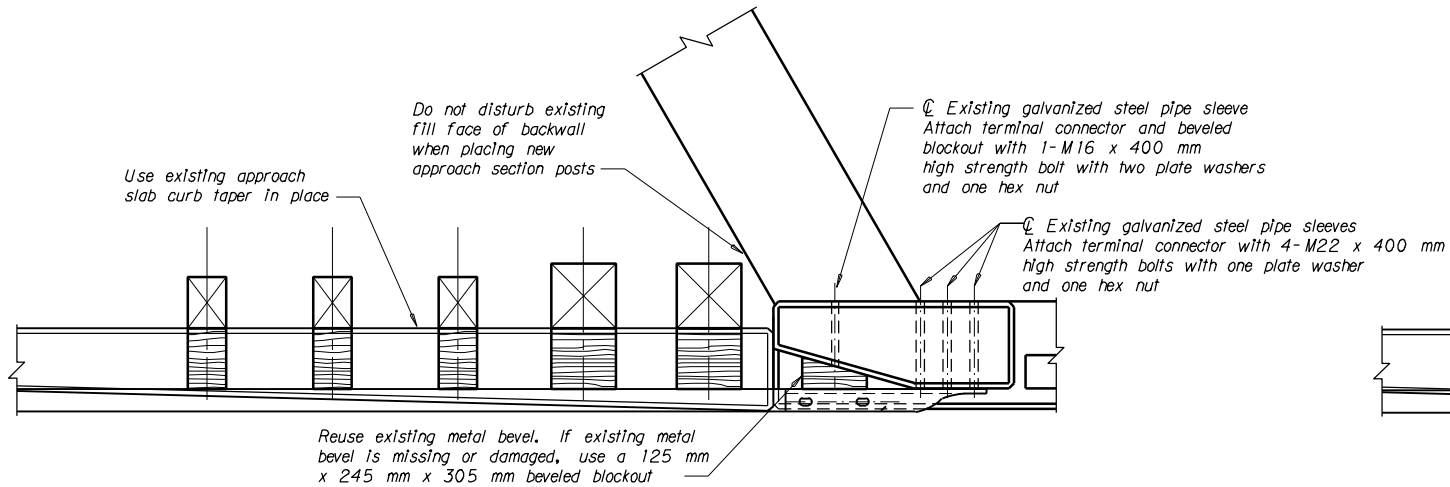

PARTIAL PLAN VIEW

NOTE: See Detailed Drawing No. 606-24 for more details and notes.

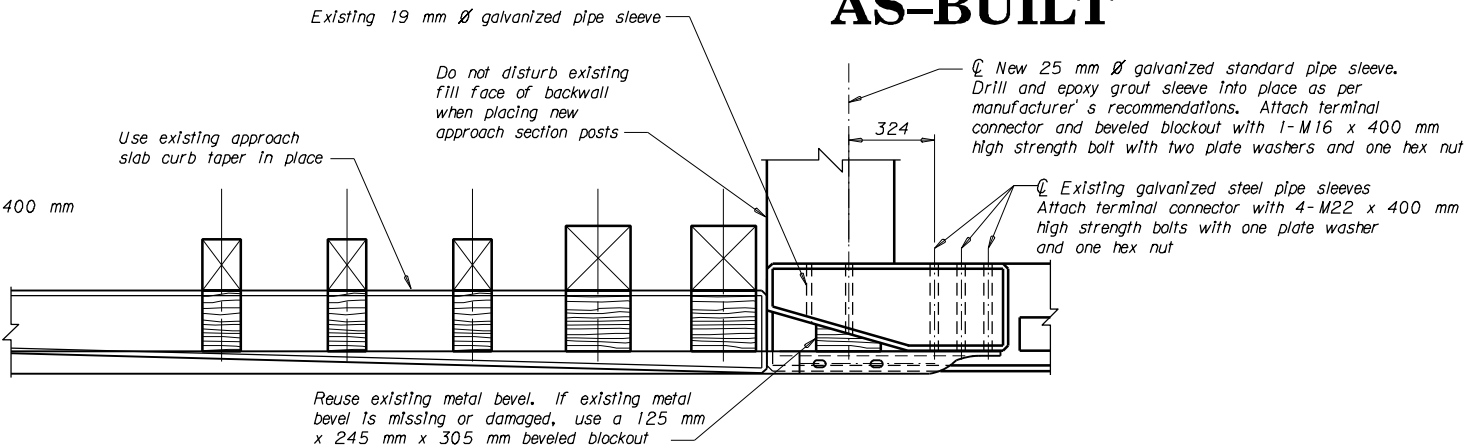


PARTIAL PLAN VIEW

NOTE: See Detailed Drawing No. 606-24 for more details and notes.


** See revised bridge approach section this sheet.

** See revised bridge approach section this sheet.

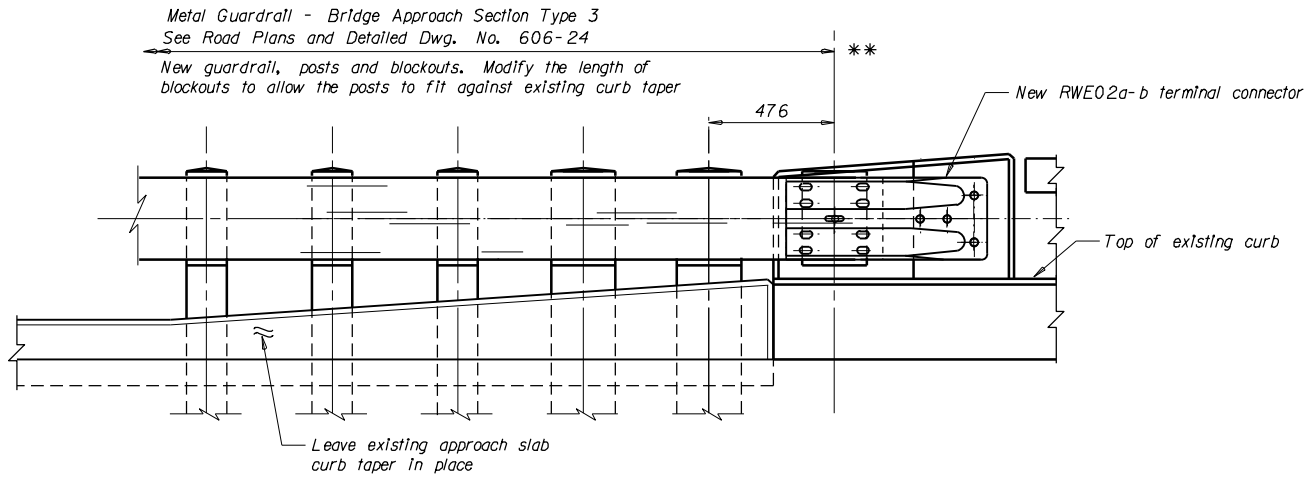

PARTIAL ELEVATION VIEW


R. P. P00 020 032+0.107
R. P. P00 020 032+0.399
R. P. P00 020 032+0.652
R. P. P00 020 046+0.683
R. P. P00 022 065+0.625
R. P. P00 057 161+0.243
R. P. P00 057 187+0.853

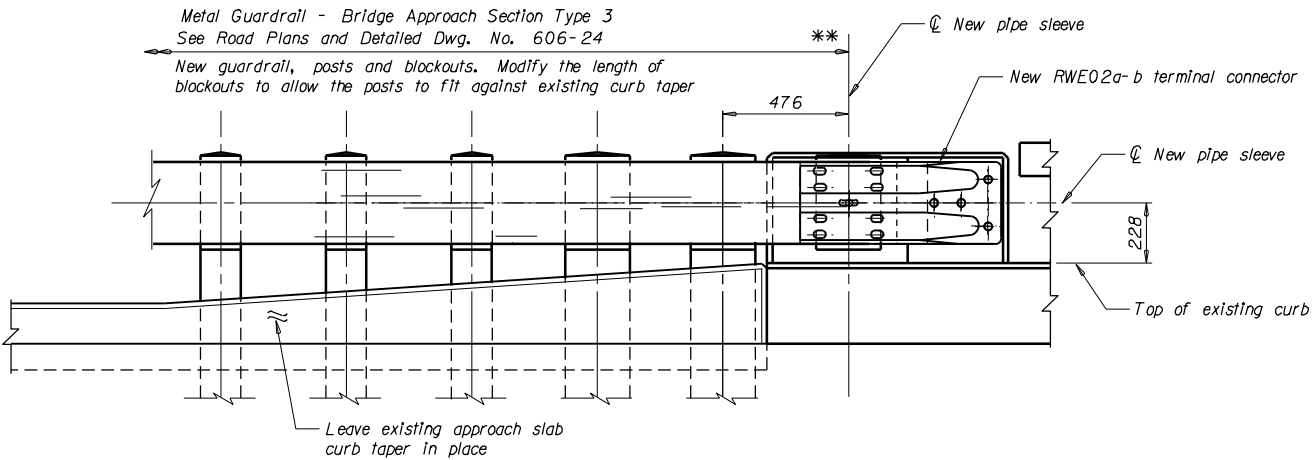

PARTIAL ELEVATION VIEW

R. P. P00 022 075+0.877

SUMMARY TABLE								
STRUCTURE LOCATION		* GENERAL LAYOUT DRAWING NO.	BRIDGE APPROACH SECTIONS		RAIL ATTACHMENT STATIONS (METERS)			
			New Curb Tapers	TYPE 3				
Route N-20	032+0.107	10466	NO	4	BENT 1 LEFT 10 + 30.48	BENT 1 RIGHT 10 + 30.48	BENT 2 LEFT 9 + 69.52	BENT 2 RIGHT 9 + 69.52
Route N-20	032+0.399	10470	NO	4	BENT 1 LEFT 10 + 30.48	BENT 1 RIGHT 10 + 30.48	BENT 4 LEFT 9 + 69.52	BENT 4 RIGHT 9 + 69.52
Route N-20	032+0.652	10475	NO	4	BENT 1 LEFT 10 + 00.00	BENT 1 RIGHT 10 + 00.00	BENT 2 LEFT 9 + 69.52	BENT 2 RIGHT 9 + 69.52
Route N-20	046+0.683	10366	NO	4	BENT 1 LEFT 10 + 53.34	BENT 1 RIGHT 10 + 53.34	BENT 4 LEFT 9 + 69.52	BENT 4 RIGHT 9 + 69.52
Route N-22	065+0.625	11058	YES (4)	4	BENT 1 LEFT 10 + 30.48	BENT 1 RIGHT 10 + 30.48	BENT 6 LEFT 9 + 69.52	BENT 6 RIGHT 9 + 69.52
Route N-22	075+0.877	9626	NO	4	BENT 1 LEFT 10 + 15.24	BENT 1 RIGHT 10 + 11.43	BENT 3 LEFT 9 + 50.47	BENT 3 RIGHT 9 + 50.47
Route N-57	161+0.243	10821	NO	4	BENT 1 LEFT 10 + 30.48	BENT 1 RIGHT 10 + 30.48	BENT 3 LEFT 9 + 69.52	BENT 3 RIGHT 9 + 69.52
Route N-57	187+0.853	10521	NO	4	BENT 1 LEFT 10 + 30.48	BENT 1 RIGHT 10 + 30.48	BENT 2 LEFT 9 + 69.52	BENT 2 RIGHT 9 + 69.52

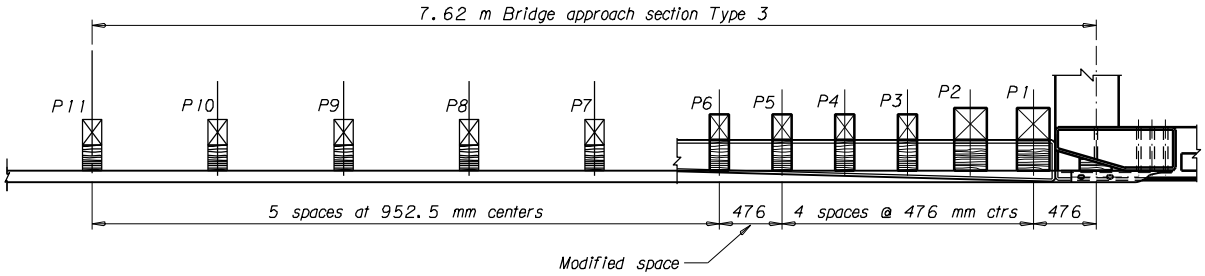

** REVISED TYPE 3 BRIDGE APPROACH SECTION

NOTES

PAYMENT: Guardrail - Steel/Bridge Approach Type 3 is paid for by the unit price bid which is full compensation for all resources necessary to complete the item.

Plug predrilled holes in rail with standard splice bolts. See Detailed Dwg. No. 606-82.

D4-NON-INTERSTATE GUARDRAIL
ON ROUTES N-20, N-22 AND N-57
FEDERAL AID PROJECT NO. NHTSA 0002(393)
RICHLAND COUNTY


BRIDGE APPROACH SECTIONS

4-25-03 L. M. S.
4-28-03 L. M. S.
6-19-03 D. J. R.
12-9-03 L. M. S.


** REVISED

Scale ~ 1 : 15


* NOTE: The General Layouts are available from the MDT Bridge Bureau.

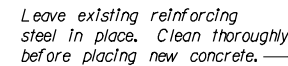

Bent No. 1 - Left side only

 


Bent No. 1 - Left side only

 


SECTION B-B

NOTE: Use zinc-coated steel wire (7) strand utilities grade wire rope with minimum breaking strength of 111.2 kN conforming to ASTM A 475.

NOTE: Use a connecting pin meeting the requirements of AASHTO M 227M Grade 310.

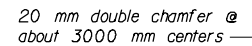

BARRIER DETAIL

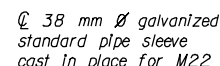

SIDE VIEW

END VIEW

VIEW A-A

[illegible]

NOTES:

PAYMENT: Include all costs associated with furnishing materials, equipment, labor and Incidentals necessary to complete the Item in the unit price bid for Guard Rail - Steel/Bridge Approach Type 1.

General Layout Dwg. No. 13438 is available from the MDT Bridge Bureau.


Use Class SD concrete in barrier. Galvanize all new hardware.

4-25-03 L. M. S.
4-28-03 L. M. S.
6-19-03 D. J. R.


D4-NON-INTERSTATE GUARDRAIL
ROUTE N-20 AT RP 37+0.515
PROJECT NO. NHTSA 0002(393)

RICHLAND COUNTY
BARRIER END MODIFICATION

Scale ~ No Scale

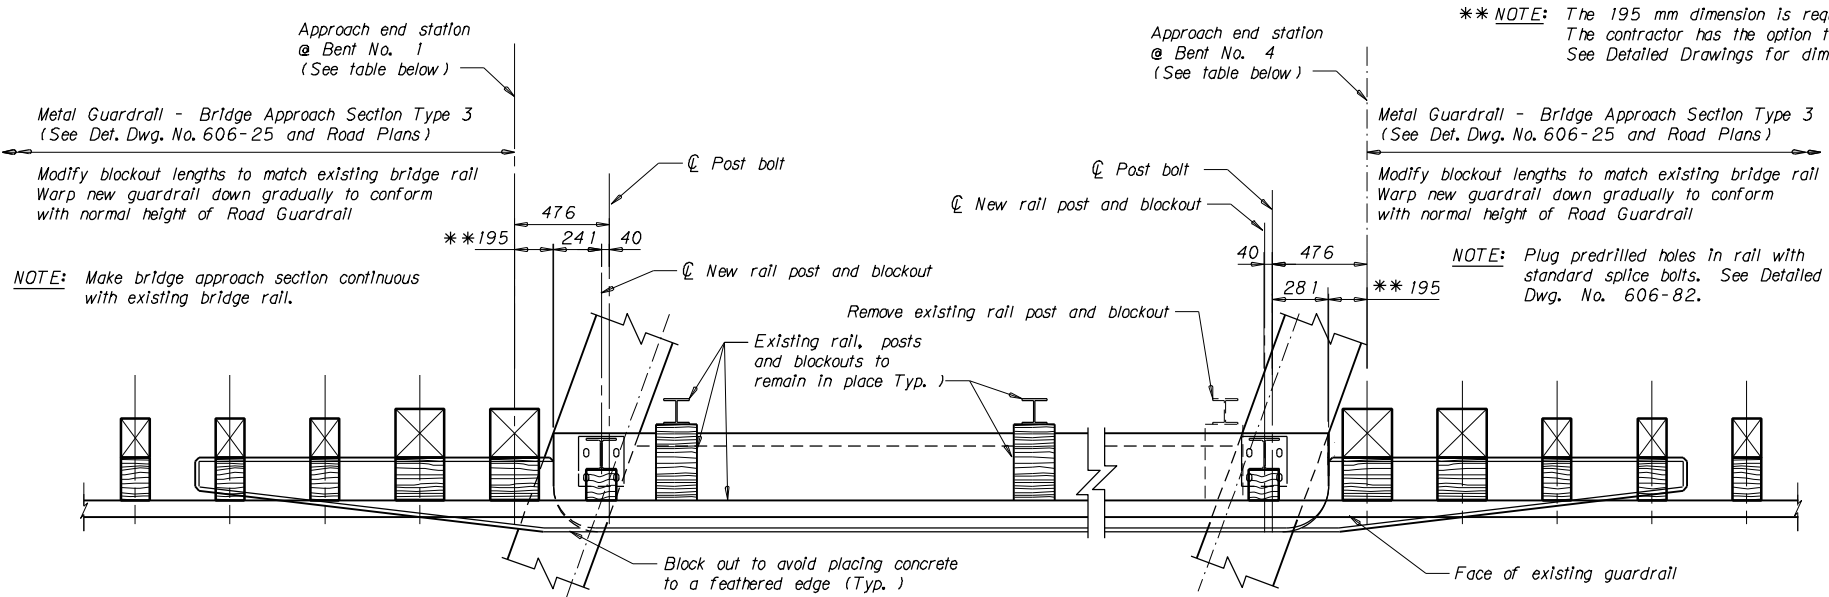


PARTIAL PLAN VIEW

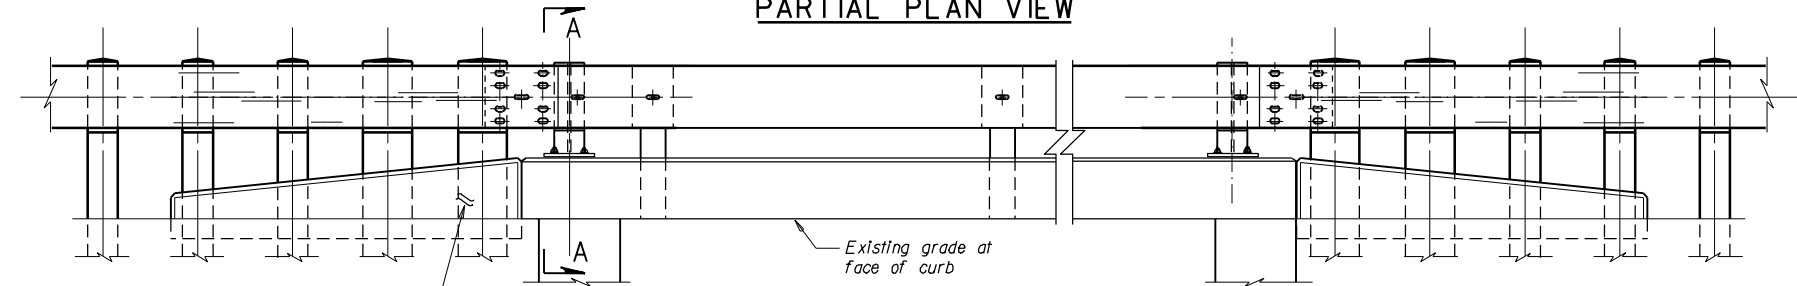


PARTIAL ELEVATION VIEW

RAIL REVISION SUMMARY TABLE (Details shown apply to both sides and ends of the structure)					
STRUCTURE LOCATION	GENERAL LAYOUT DWG. NO.	SKEW	TYPE 3 BRIDGE APPROACH SECTIONS (EACH)	APPROACH END STATIONING	
				BENT NO. 1	BENT NO. 4
Route N-23	015+0.943	* 5155	20°	4	
				10 + 22.86 Rt. 10 + 22.86 Lt.	9 + 77.14 Rt. 9 + 77.14 Lt.

* NOTE: The General Layout is available from the MDT Bridge Bureau.

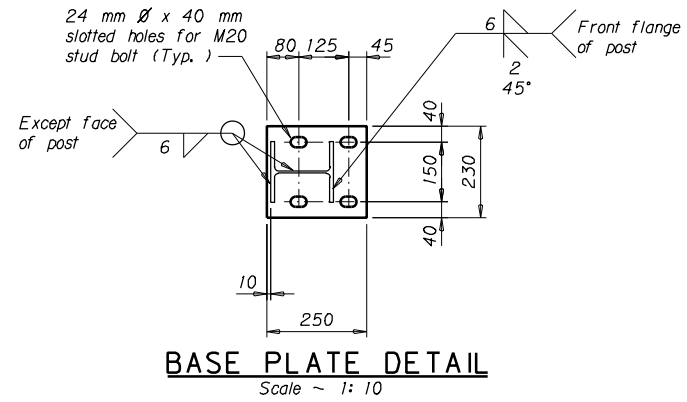


BASE PLATE DETAIL

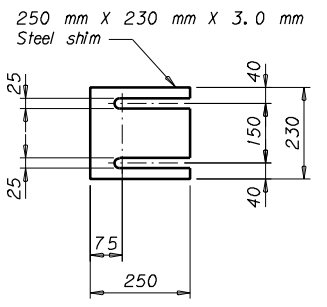


RAIL POST SHIM DETAIL


NOTE: Furnish shims as necessary to adjust rail to grade. Place shims between fiber reinforced pads. Place shims with slots toward roadway centerline.

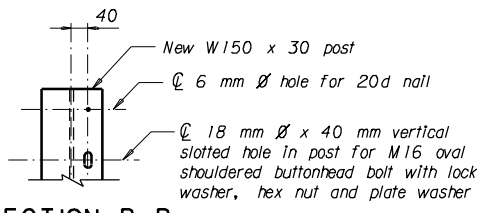

SECTION B-B

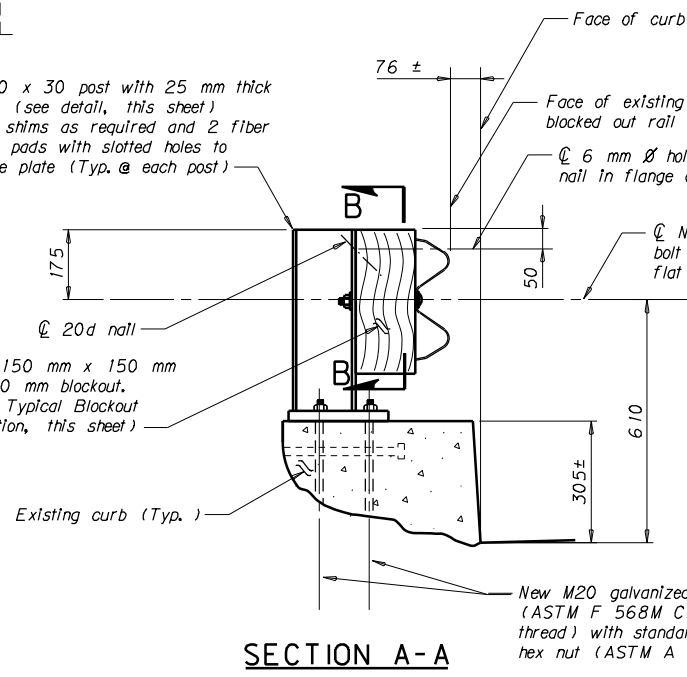

SECTION A-A

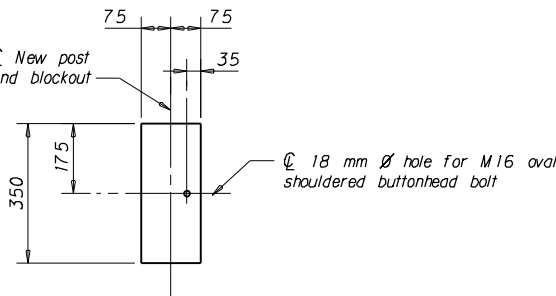

TYPICAL BLOCKOUT ELEVATION

PAINTING: Paint all posts and plates (except as noted) in accordance with the Standard Specifications. Galvanizing the posts and plates in accordance with AASHTO M 111M will be allowed.

REFLECTORS: Place a reflector on each end rail post and at approximately equal spacing (every third rail post but not to exceed 7620 mm) between end rail posts. Mount reflectors with reflectorized face toward oncoming traffic. See Dtl. Dwg. No. 606-05B for reflector detail.

PAYMENT: Include all costs associated with furnishing materials, equipment, labor and Incidentals necessary to complete the item in the unit price bid for Guard Rail - Steel/Bridge Approach Type 3. Use new posts and plates conforming to AASHTO M 270M Grade 250T3. Use metal guardrail conforming to AASHTO M 180 and lap in direction of traffic.

ERECTION: Set the rail parallel to the roadway grade. Adjust rail to proper rail height using vertical slots in rail post or rail post shims.

Cut existing rail sections square. Flame cutting is not permitted. Coat new cut ends and holes with an approved galvanizing paint.



Place blockouts made of treated timber with the wood grain perpendicular to the bolt centerline.

D4-NON-INTERSTATE GUARDRAIL
ON ROUTE N-23 AT RP 15+0.943
FEDERAL AID PROJECT NO. NHTSA 0002(393)
CUSTER COUNTY
BRIDGE APPROACH SECTIONS

4-29-03 L. M. S.
4-30-03 L. M. S.
6-21-03 D. J. R.


REVISED

Scale ~ 1 : 20 except as noted

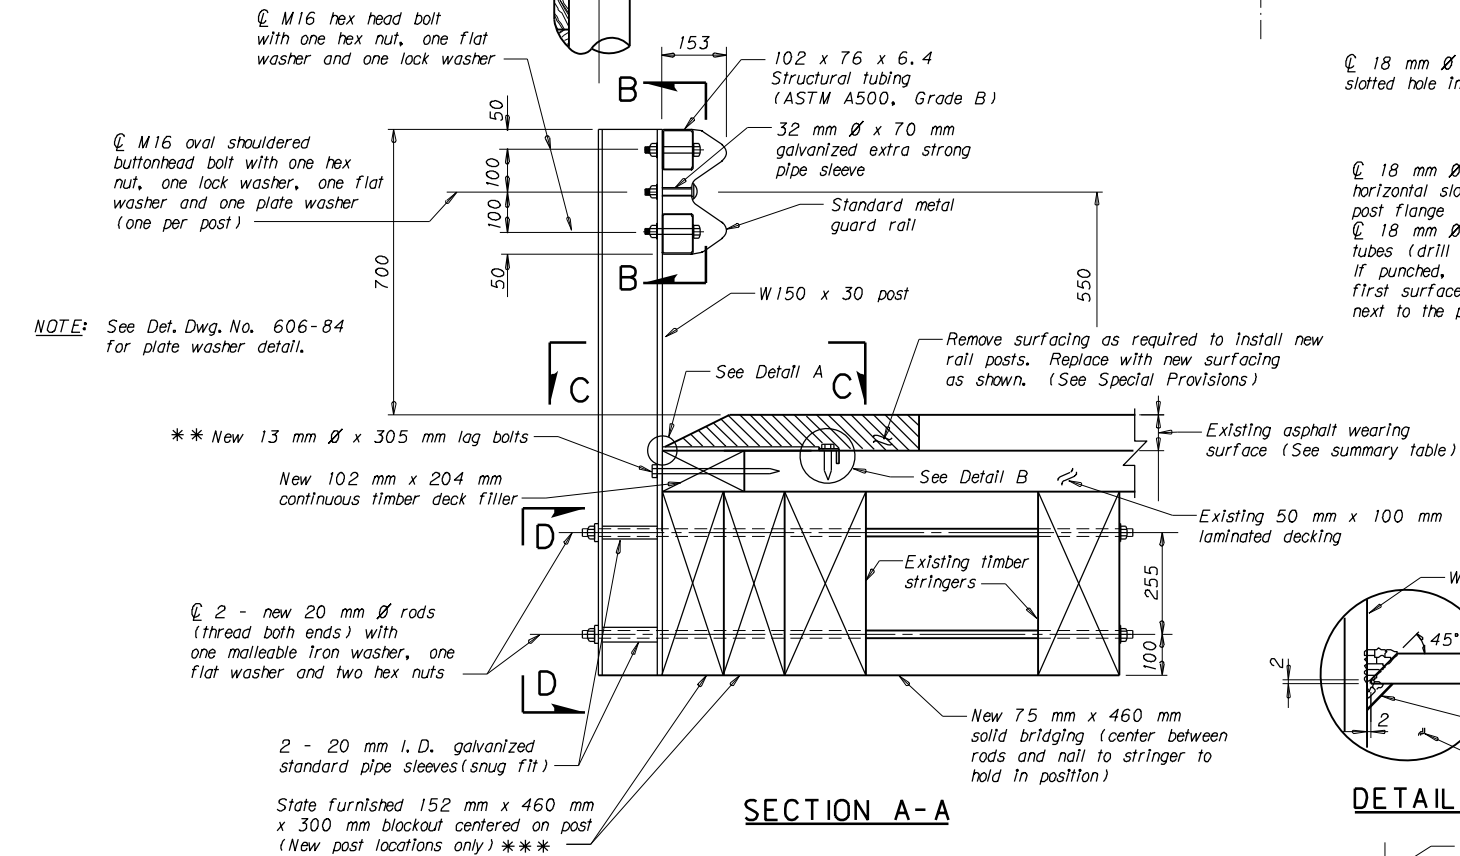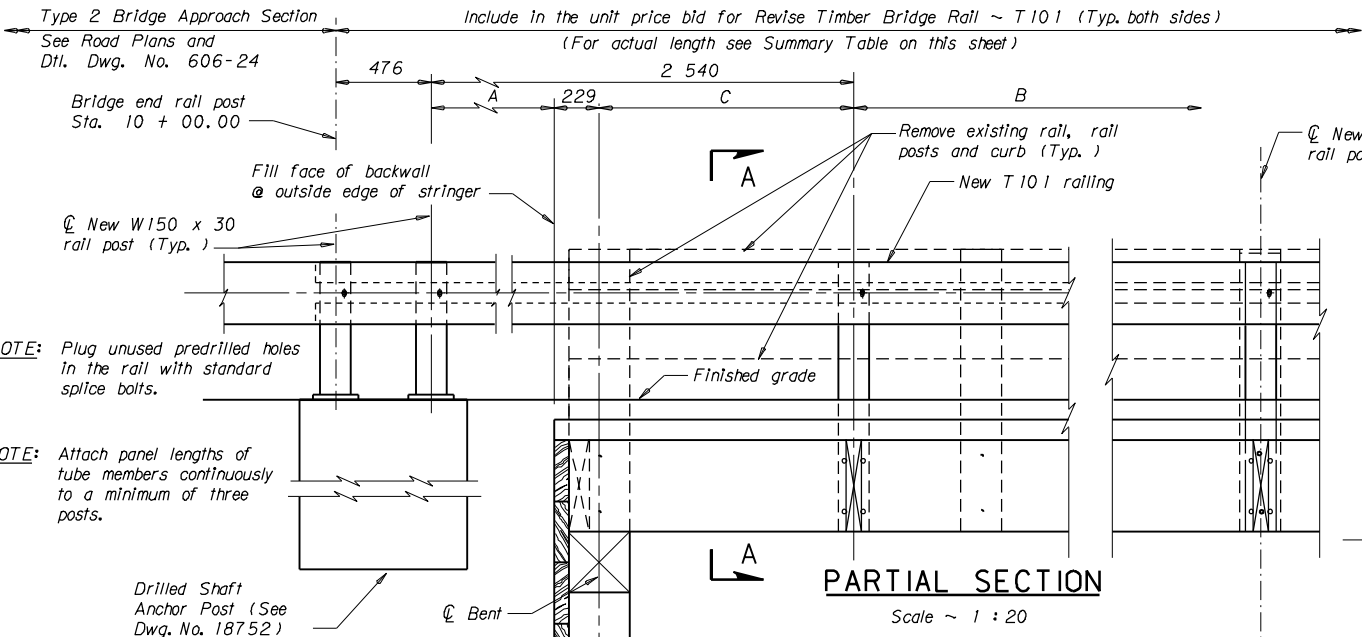


*** NOTE: Run new 102 mm x 204 mm deck filler continuous along existing deck edge.
Center filler ends at new posts. Equally space 3-13 mm \varnothing x 305 mm log bolts between posts.

*** NOTE: The State of Montana will supply salvaged stringers for the contractor to cut into 300 mm lengths.
The stringers will be stock piled for the contractor's use at a maintenance yard stated in
the Special Provisions




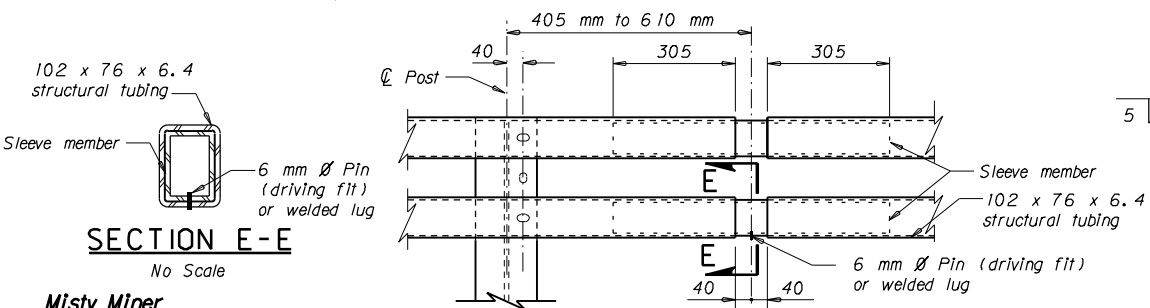


Misty Miner
22-10-2005




TUBE SPLICE DETAIL

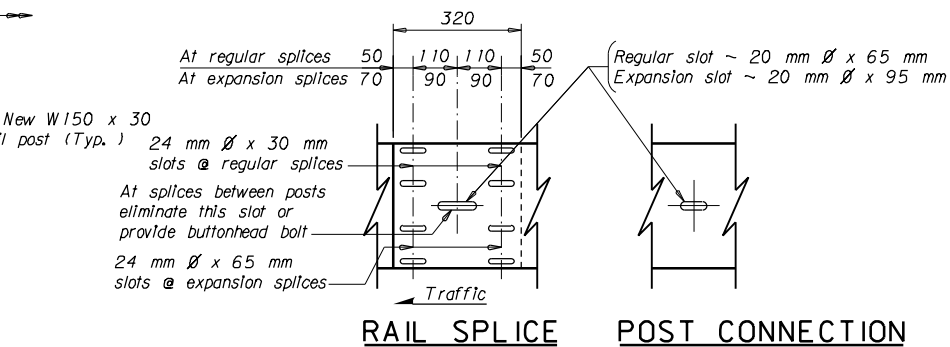

NOTE: Provide M16 oval shouldered buttonhead bolts
with hex nuts at all splice slots.

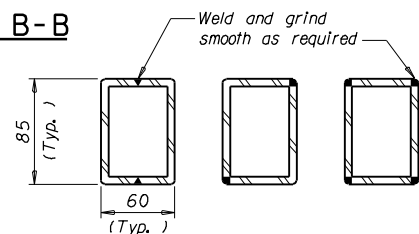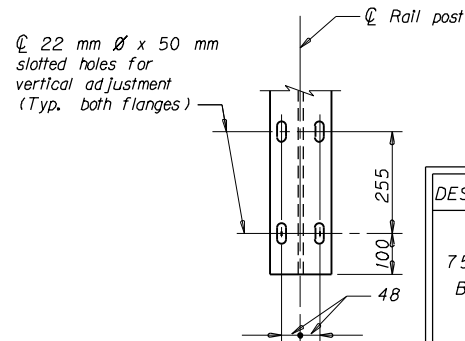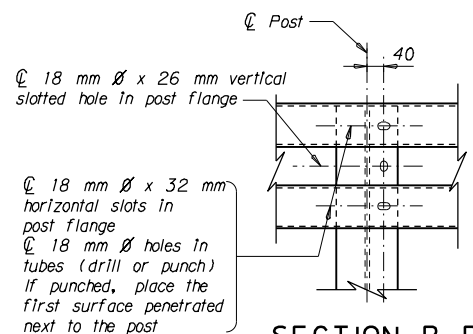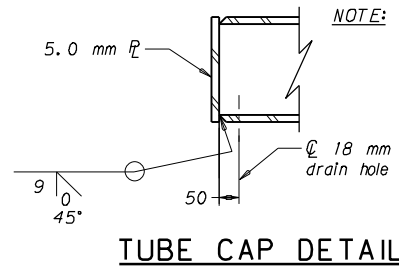

NOTE: Other sections of equal or greater
strength with 6 mm minimum wall
thickness are acceptable for sleeves.

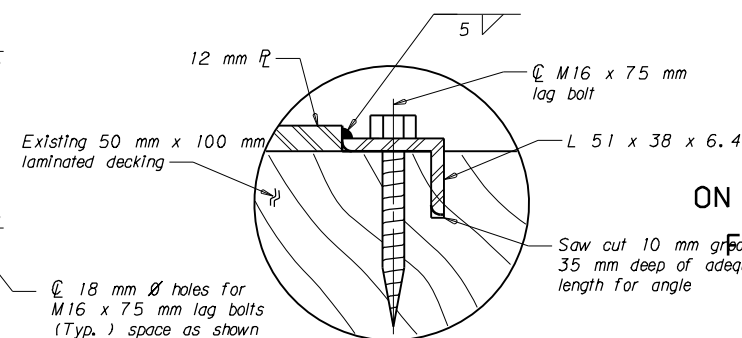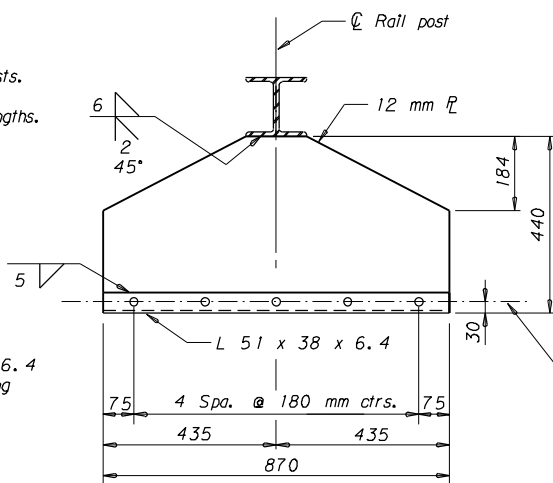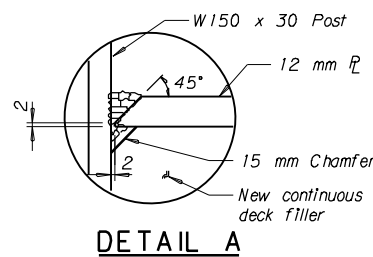

AS-BUILT

NHTSA 0002(393)

B8

NOTES

REFLECTORS: Place a reflector on each end rail post and at approximately equal spacing
(every third rail post but not to exceed 7620 mm) between end rail posts. Mount reflectors
with reflectorized face toward oncoming traffic. See Detail see Dtl. Dwg. No. 606-05 for
reflector detail. Mount reflector to W-beam post web with an approved adhesive. Include the
cost of the reflector in the unit price bid for Revise Timber Bridge Rail - T101.

PAYMENT: Revise Timber Bridge Rail - T101 is paid for by the linear meter which is full
compensation for all resources necessary to complete the item. The number of linear meters
of Revise Timber Bridge Rail - T101 for payment is the distance between centerlines of
the drilled shaft posts as shown on this sheet (See Summary Table below). Use posts and plates
conforming to AASHTO M 270M Grade 250T3. Use metal guardrail conforming to AASHTO M 180
and lap in direction of traffic.

ERECTION: Set the rail parallel to the roadway grade. Set rail posts perpendicular to adjacent
roadway grade and vertical in relation to roadway cross slopes. Adjust rail to proper rail height
using vertical slots in rail posts.

PAINTING: Paint all posts, structural tubing and plates (except as noted) in accordance with
the Standard Specifications. Galvanizing the posts, structural tubing and plates in accordance with
AASHTO M 111M is allowed.

SELECT STRUCTURAL TIMBER FOR SOLID BRIDGING: Use standard sawn inter-mountain
Douglas Fir, Western Larch or Pacific Coast Douglas Fir conforming to AASHTO M 168 meeting
the requirements for numerical stress values shown on the table below for Dense No. 1 timber
for solid bridging. Clearly note the grade of timber on the shop plans to avoid oversight. AASHTO
classification for solid bridging is Beams and Stringers.

DESCRIPTION	EXTREME FIBER IN BENDING F_b & TENSION PARALLEL TO GRAIN F_t (MPa)		HORIZ. SHEAR F_v (MPa)	COMPRESSION (MPa)		MODULUS OF ELASTICITY E (MPa)
				PERPENDICULAR TO GRAIN $F_{c\perp}$	PARALLEL TO GRAIN F_c	
75 x 460 Bridging	F_b	F_t	0.59	5	7.6	11 700
	10.7	5.3				

Details shown on this drawing apply to both sides for the entire length of the structure.

Remove existing rails, rail posts, curb and hardware as shown on this drawing.
Removed items become the property of the contractor. (See Special Provisions
for disposal of unwanted materials.) Removal costs are included in the unit price
bid for Revise Timber Bridge Rail - T101.

Replace any timber which is to be incorporated in the rehabilitated structure that is damaged during
construction at no additional cost to the State.

Chamfer edge of new timber deck filler directly under location where 12 mm plate connects with rail
post to clear fillet weld as shown in Detail A.

Plug open holes exposed by revisions with treated dowels. Thoroughly coat all new holes, cuts
and chamfers as per Standard Specifications.

RAIL REVISION SUMMARY TABLE (Details shown apply to both sides of the structure)

RAIL REVISION SUMMARY TABLE <i>(Details shown apply to both sides of the structure)</i>										
STRUCTURE LOCATION		GENERAL LAYOUT DWG. NO.	SKEW	WEARING SURFACE DEPTH (mm)	DIMENSIONS			LENGTH OF RAIL (ONE SIDE ONLY) (m)	TOTAL LENGTH FOR PAYMENT (m)	ANCHOR POST (EACH)
					A	B	C			
Route N-57	231+0.023	1809	0°	152 ±	1 244	6 Spa. @ 2 540 = 15 240	1 067	21.272	42.544	4
Route N-57	232+0.710	1809	0°	152 ±	889	8 Spa. @ 2 540 = 20 320	1 422	26.352	52.704	4





D4-NON-INTERSTATE GUARDRAIL
ON ROUTE N-57 AT RP 231+0.023 & 232+0.710
FEDERAL AID PROJECT NO. NHTSA 0002(393)
GARFIELD COUNTY

BRIDGE RAIL REVISION



3-14-03 LMS/KFM
3-18-03 L.M.S.
6-21-03 D.J.R.

REVISED

Scale ~ 1 : 10 except as noted

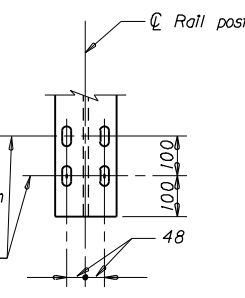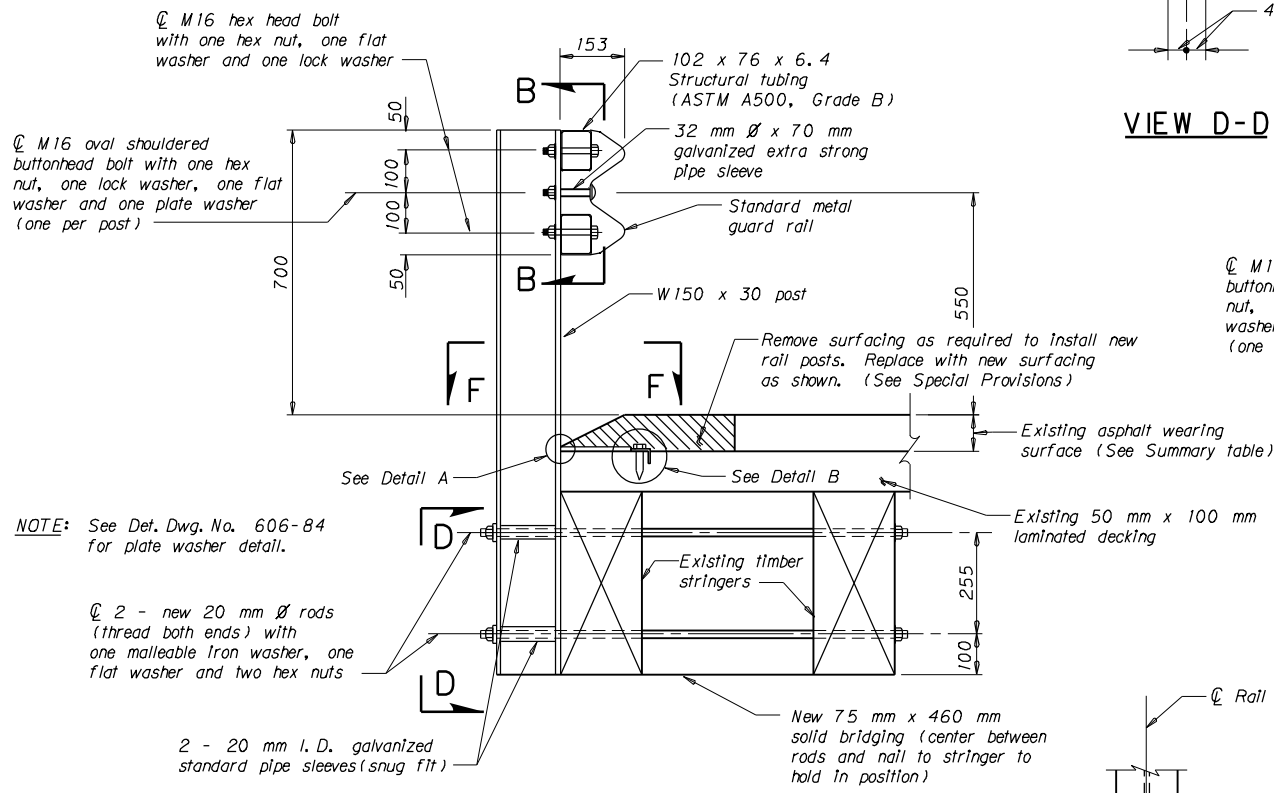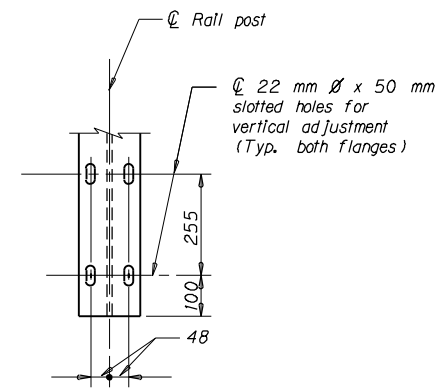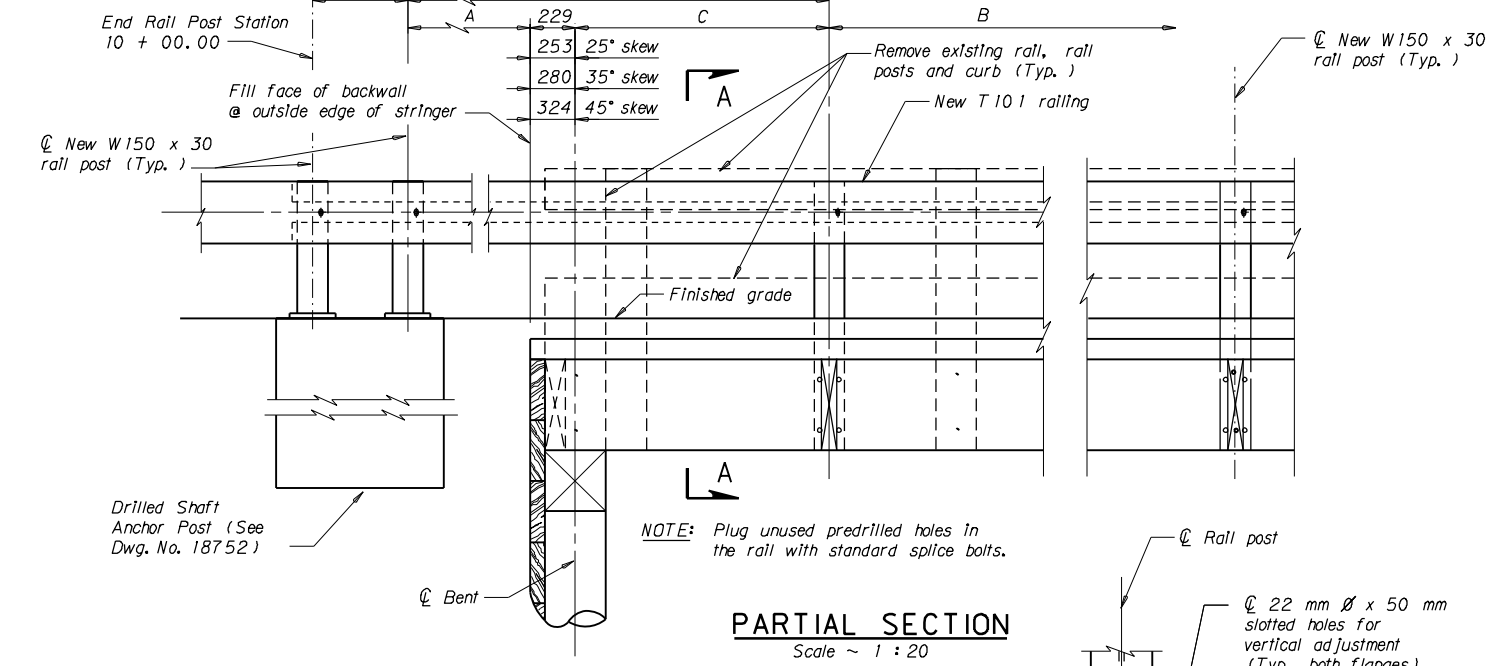

RAIL REVISION SUMMARY TABLE (Details shown apply to both sides of the structure)										
STRUCTURE	LOCATION	GENERAL LAYOUT DWG. NO.	SKEW	WEARING SURFACE DEPTH (mm)	DIMENSIONS			LENGTH OF RAIL (ONE SIDE ONLY) (m)	TOTAL LENGTH FOR PAYMENT (m)	ANCHOR POST (EACH)
					A	B	C			
Route N-1	645+0.625	3700	0°	178 ±	1 244	6 Spa. @ 2 540 = 15 240	1 067	21.272	42.544	4
Route N-57	232+0.566	2057	0°	152 ±	1 041	2 Spa. @ 2 540 = 5 080	1 270	11.112	22.224	4
Route N-57	234+0.523	2176	0°	178 ±	889	11 Spa. @ 2 540 = 27 940	1 422	33.972	67.944	4
Route N-57	235+0.652	2057	35°	178 ±	787	10 Spa. @ 2 540 = 25 400	1 473	31.432	62.864	4
Route N-57	247+0.394	1949A	0°	102 ±	1 803	11 Spa. @ 2 540 = 27 940	508	33.972	67.944	4
Route N-57	248+0.831	1812	25°	178 ±	1 017	14 Spa. @ 2 540 = 35 560	1 270	41.592	83.184	4
Route N-57	249+0.748 Lt.	1813	0° / 45°	178 ±	635~0° 540~45°	15 Spa. @ 2 540 = 38 100	1 676	44.132	80.644	2
Route N-57	249+0.748 Rt.	1813	0° / 45°	178 ±	787~0° 692~45°	12 Spa. @ 2 540 = 30 480	1 524	36.512		2
Route N-57	253+0.331	1813	0°	203 ±	787	9 Spa. @ 2 540 = 22 860	1 524	28.892	57.784	4
Route N-57	254+0.769	1813A	45°	229 ±	692	9 Spa. @ 2 540 = 22 860	1 524	28.892	57.784	4
Route N-57	254+0.838	1813A	0°	229 ±	889	8 Spa. @ 2 540 = 20 320	1 422	26.352	52.704	4
Route N-57	255+0.300	1813A	35°	203 ±	482	10 Spa. @ 2 540 = 25 400	1 778	31.432	62.864	4
Route N-57	257+0.150	1813A	0°	203 ±	1 041	8 Spa. @ 2 540 = 20 320	1 270	26.352	52.704	4
Route N-57	260+0.150	1814	0°	279 ±	1 905	1 Spa. @ 2 540 = 2 540	406	8.572	17.144	4
Route N-61	133+0.425	2280	0°	102 ±	1 041	11 Spa. @ 2 540 = 27 940	1 270	33.972	67.944	4
Route N-61	136+0.511	2280	0°	102 ±	1 244	6 Spa. @ 2 540 = 15 240	1 067	21.272	42.544	4
Route N-61	137+0.076	2177	0°	127 ±	1 041	11 Spa. @ 2 540 = 27 940	1 270	33.972	67.944	4
* Route N-99	017+0.400	3044	0°	178 ±	889	8 Spa. @ 2 540 = 20 320	1 422	26.352	52.704	4

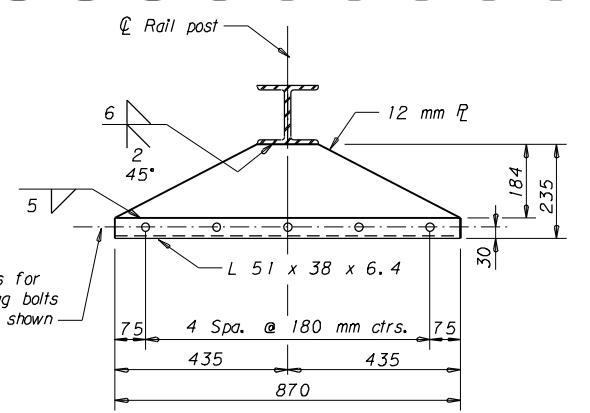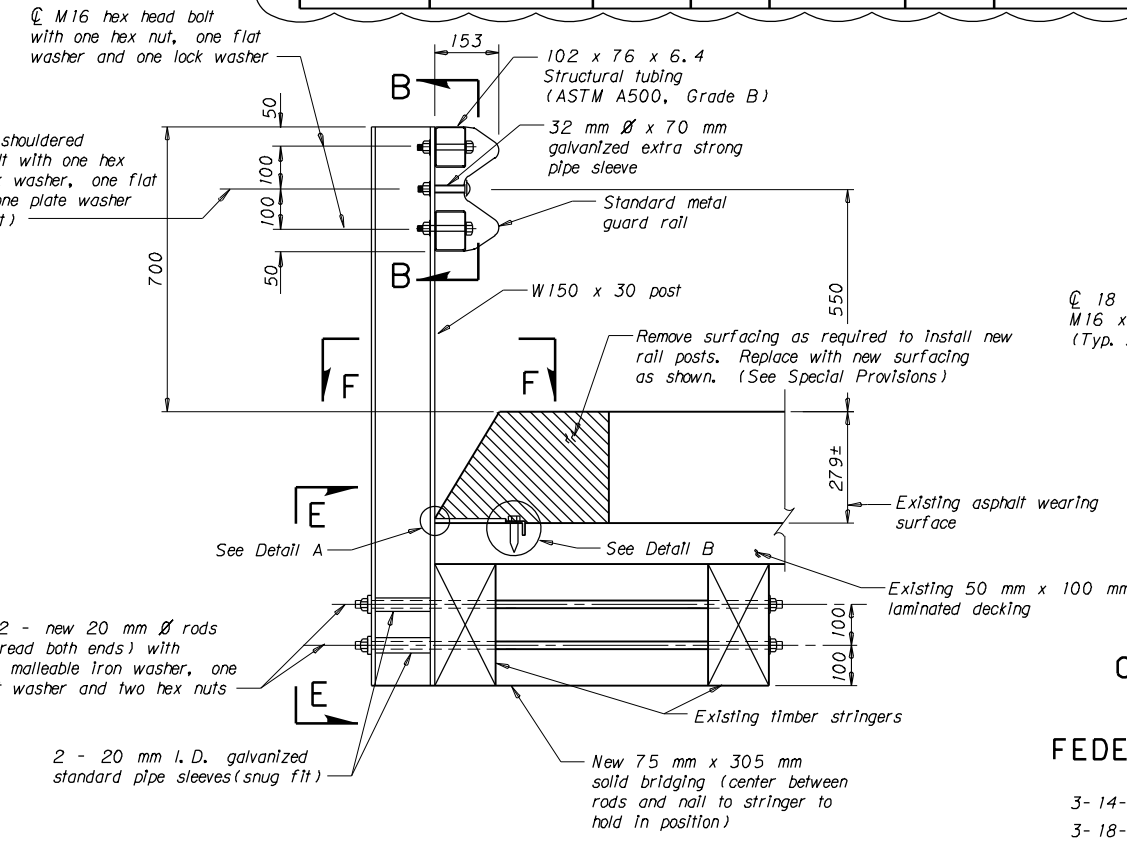

D4-NON-INTERSTATE GUARDRAIL
ON ROUTES N-1, N-57, N-61 AND N-99*
LOCATIONS AS SHOWN
FEDERAL AID PROJECT NO. NHTSA 0002(393)
VARIOUS COUNTIES
BRIDGE RAIL REVISION
Scale ~ 1 : 10 except as noted


SECTION A-A
(At Structure N-57 260+0.150 only)

Misty Miner
22-10-2005


3-14-03 LMS/KFM
3-18-03 L.M.S.
6-21-03 D.J.R.
12-9-03 L.M.S.

* REVISED

AS-BUILTS ADDENDUM NO.1 ATTACHMENT NO.4

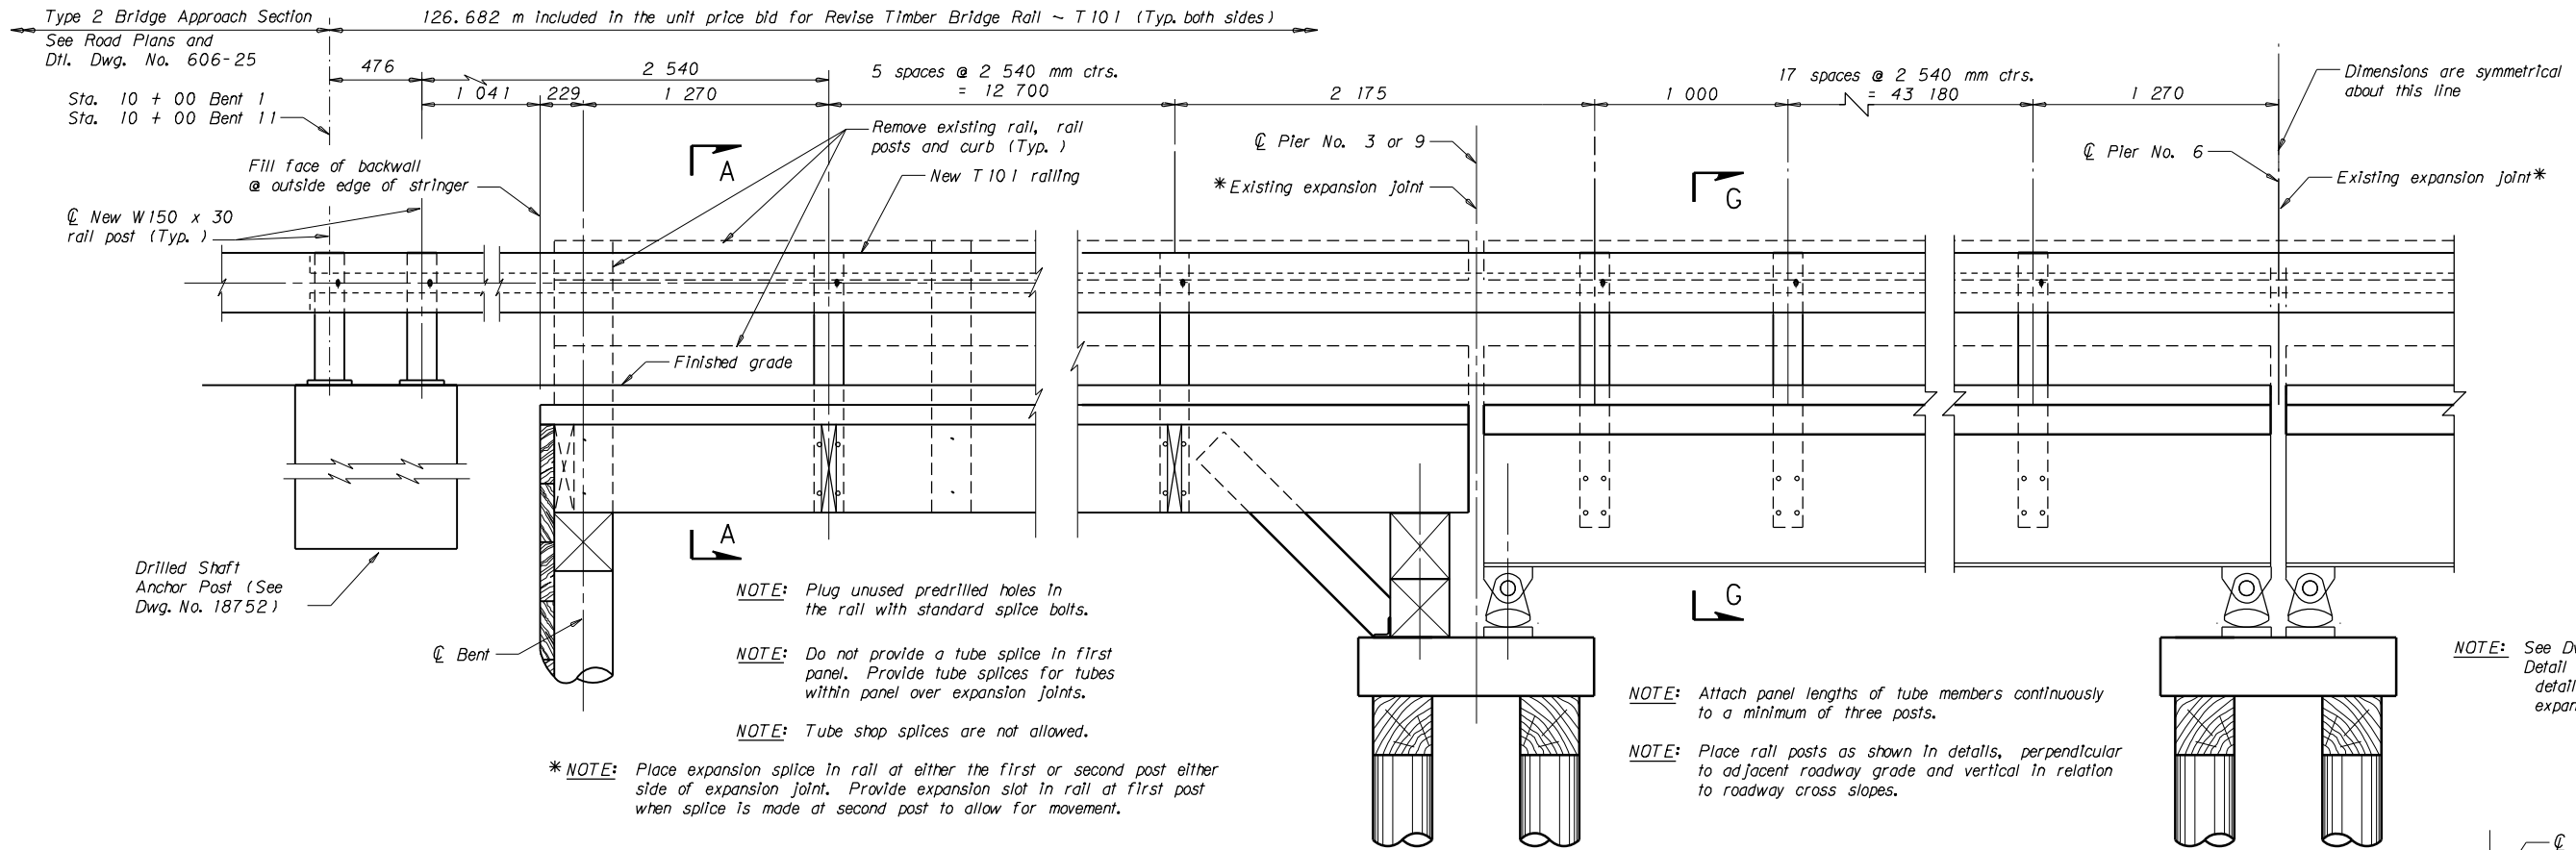


PARTIAL ELEVATION

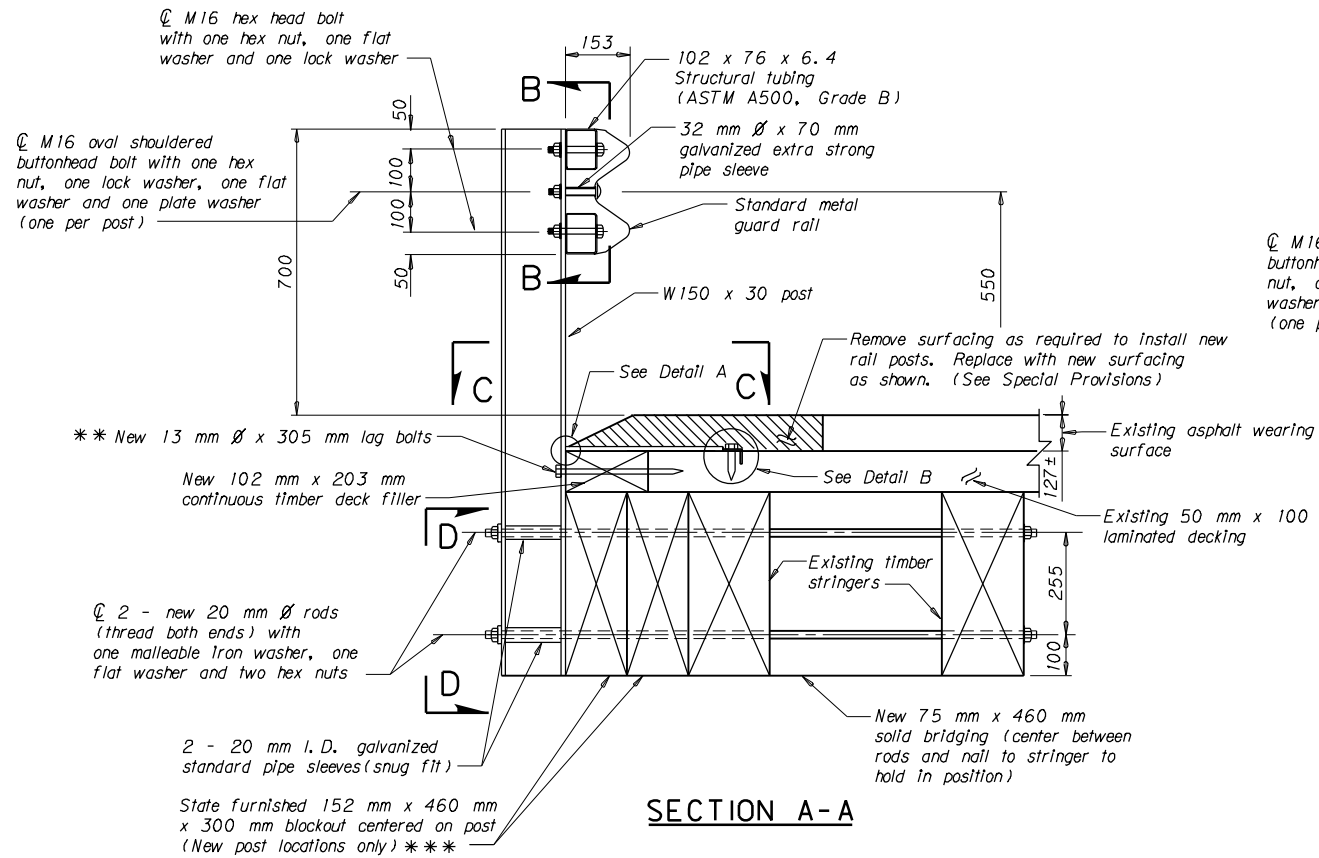

SECTION A-A


*** NOTE: Run new timber deck filler continuous along existing deck edge. Center filler ends at new posts. Equally space 3-13 mm Ø x 305 mm lag bolts between posts.

*** NOTE: The State of Montana will supply salvaged stringers for the contractor to cut into 300 mm lengths. The stringers will be stock piled for the contractor's use at a maintenance yard stated in the Special Provisions.

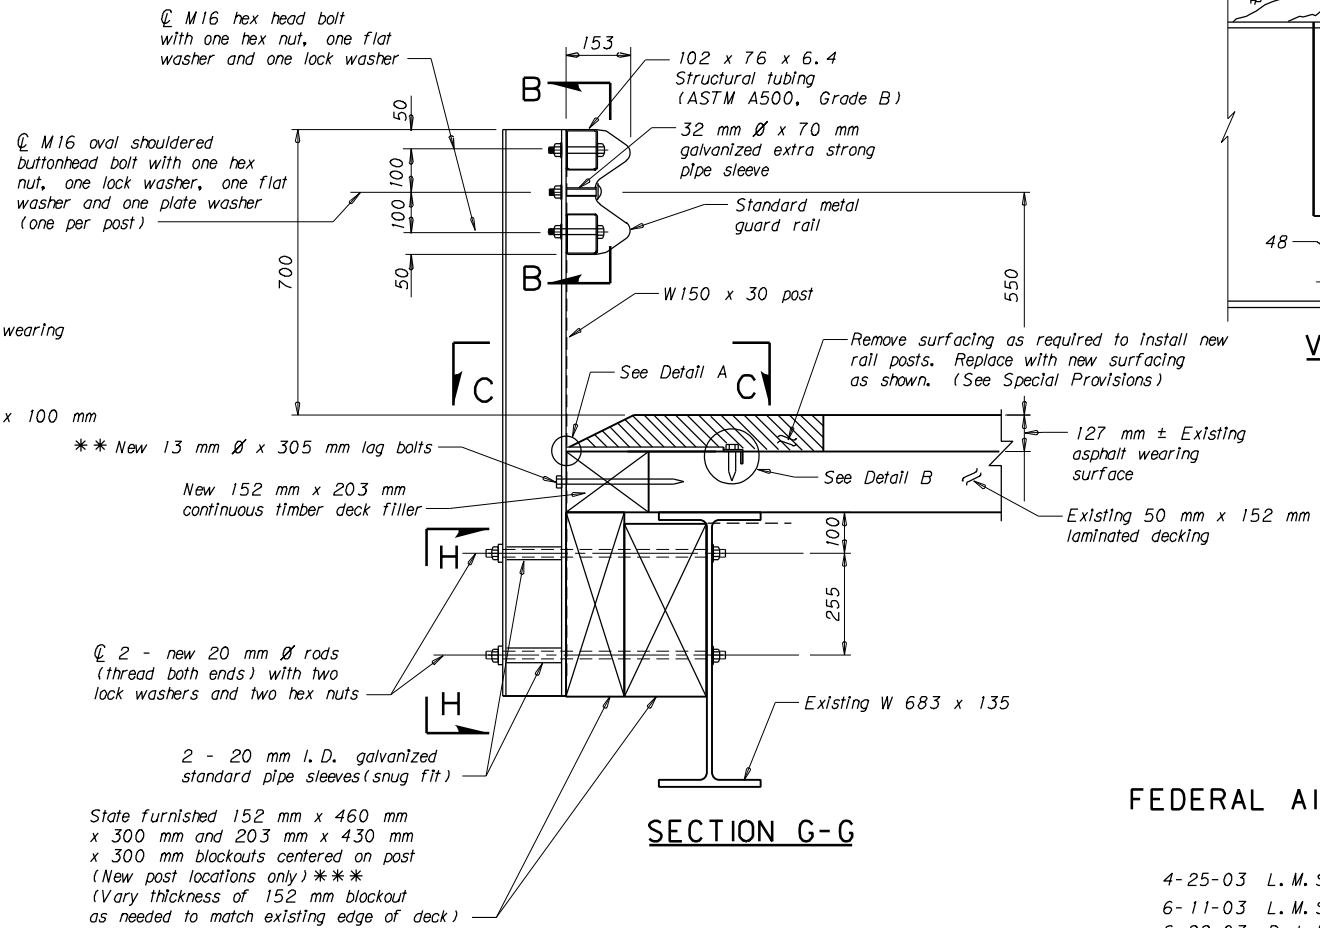

SECTION G-G

NOTE: See Det. Dwg. No. 606-84 for plate washer detail.

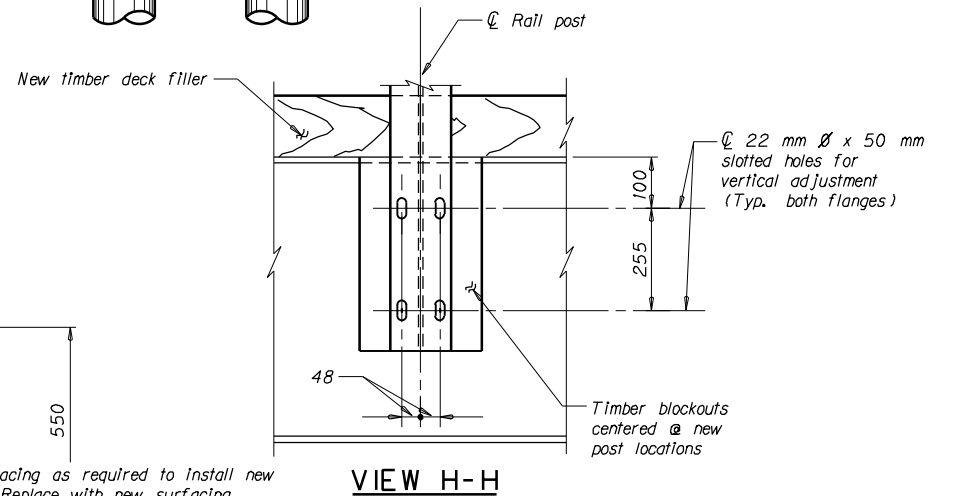

VIEW H-H


D4-NON-INTERSTATE GUARDRAIL
ON ROUTE N-57 AT RP 239+0.257
FEDERAL AID PROJECT NO. NHTSA 0002(393)
GARFIELD COUNTY
BRIDGE RAIL REVISION

4-25-03 L. M. S.
6-11-03 L. M. S.
6-22-03 D. J. R.


REVISED

Scale ~ 1 : 10 except as noted

AS-BUILTS

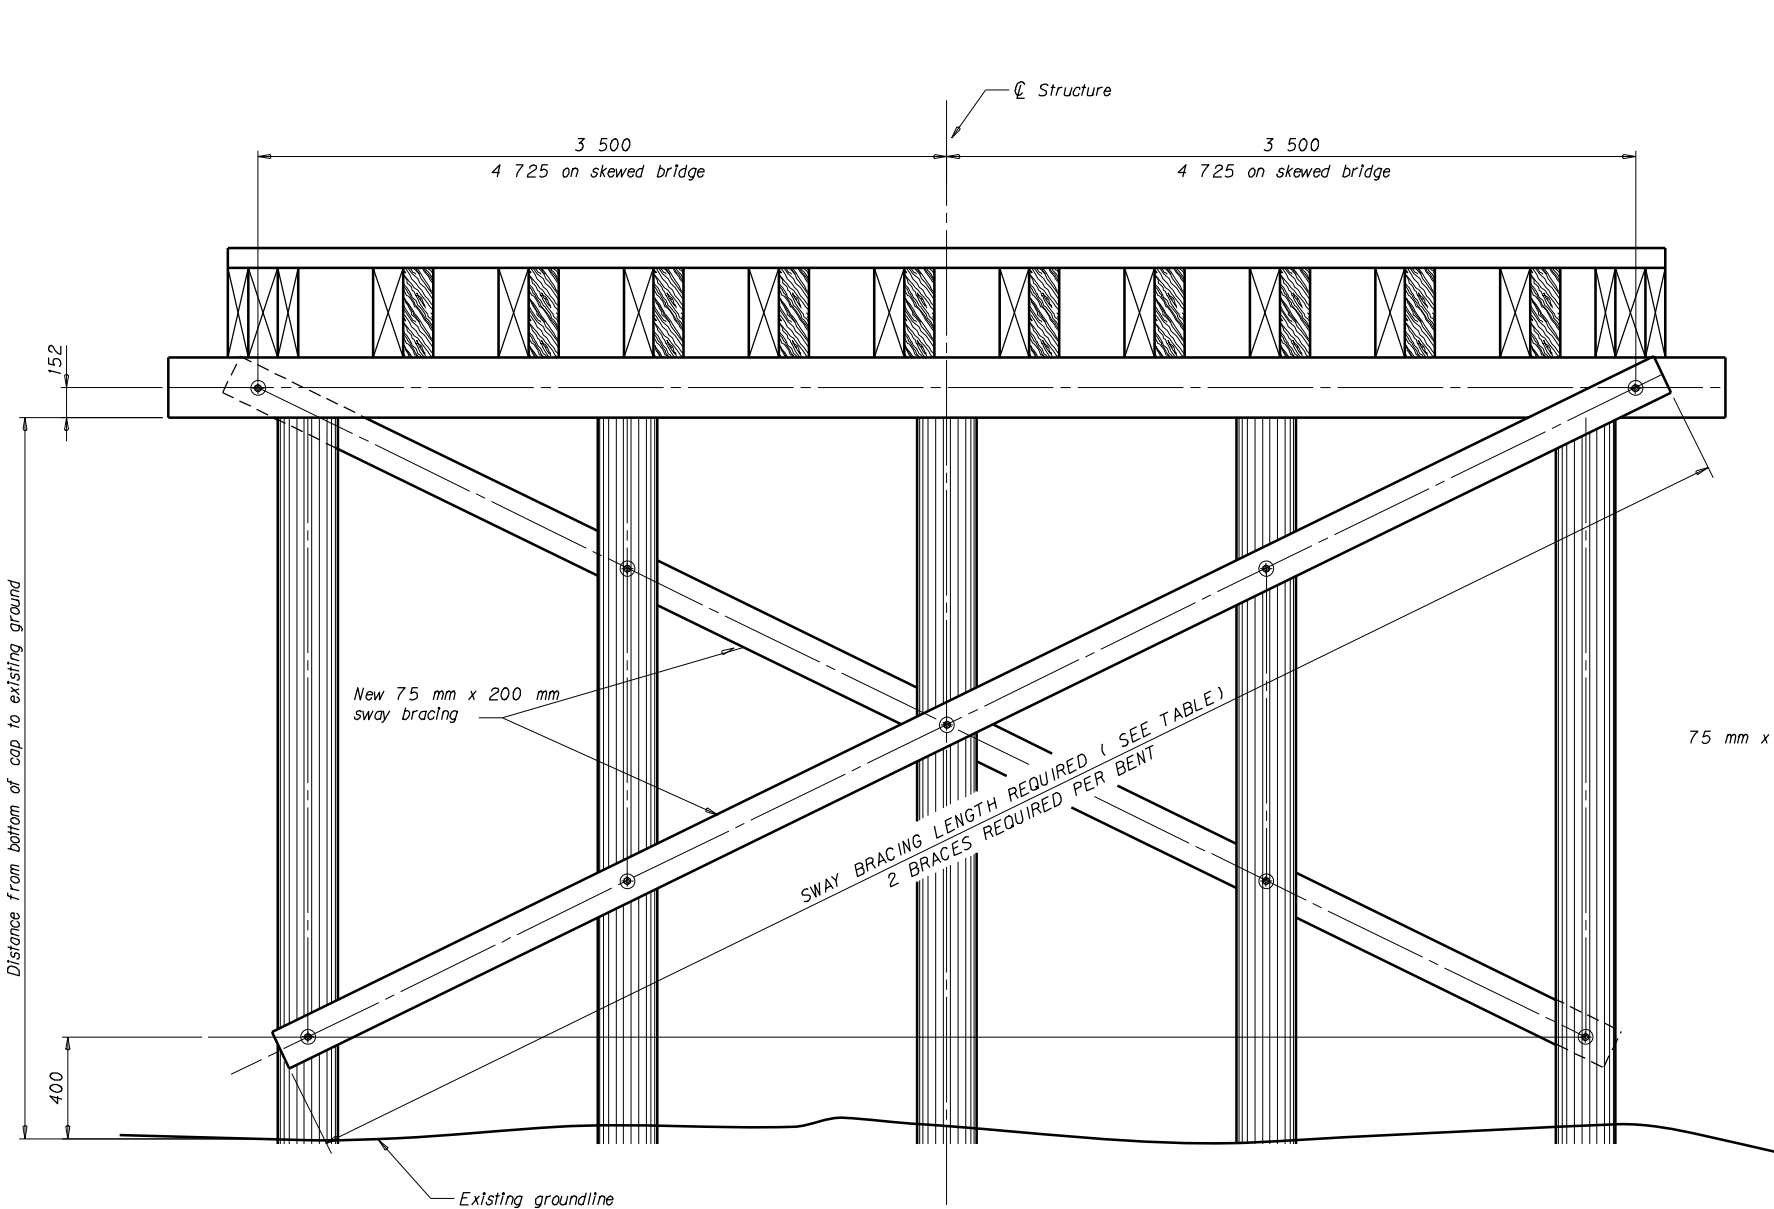

NEW SWAY BRACING DETAIL

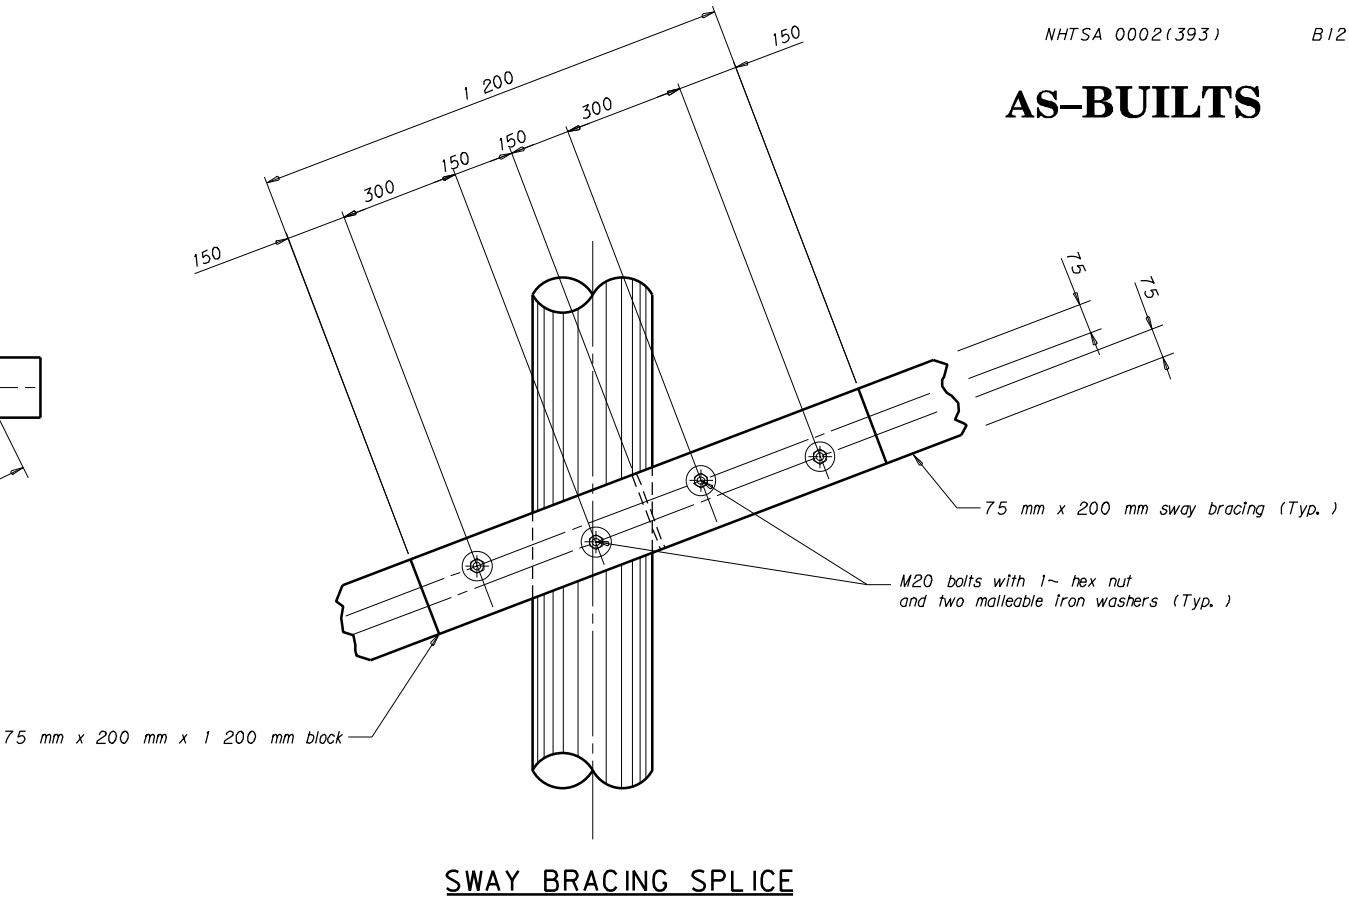

NOTES

PAYMENT: Include the sway bracing in the unit price bid for Treated Timber which is full compensation for all resources necessary to complete the item.

SELECT STRUCTURAL TIMBER FOR SWAY BRACING: Use standard sawn Inter-mountain Douglas Fir, Western Larch or Pacific Coast Douglas Fir conforming to AASHTO M 168 meeting the requirements for numerical stress values shown on the table below for Dense No. 1 timber for solid bridging. Clearly note the grade of timber on the shop plans to avoid oversight. AASHTO classification for sway bracing is Beams and Stringers.

DESCRIPTION	EXTREME FIBER IN BENDING F_b & TENSION PARALLEL TO GRAIN F_t (MPa)		HORIZ. SHEAR F_v (MPa)	COMPRESSION (MPa)		MODULUS OF ELASTICITY E (MPa)
	F_b	F_t		PERPENDICULAR TO GRAIN $F_{c\perp}$	PARALLEL TO GRAIN $F_{c\parallel}$	
75 x 200 Sway bracing			0.59	5	7.6	11 700
	10.7	5.3				

SWAY BRACING SUMMARY TABLE									
STRUCTURE LOCATION		GENERAL LAYOUT DWG. NO.	SKEW	SWAY BRACING LENGTH REQUIRED (m)				NUMBER OF SPLICES PERMITTED (EACH)	TREATED TIMBER m³
				BENT NO. 2	BENT NO. 3	BENT NO. 4	BENT NO. 5		
Route N-57	232+0.710	1809	0°	7620	7620	7620	NA	1	0.79
Route N-57	247+0.394	1949A	0°	NA	7880	NA	NA	1	0.14
Route N-57	255+0.300	1813A	35°	10 100	10 330	10 330	10 100	2	1.51

MISTY MINER
2-II-2005

D4-NON-INTERSTATE GUARDRAIL
ON ROUTE N-57 AT RP 232+0.710,
247+0.394 AND RP 255+0.300
FEDERAL AID PROJECT NO. NHTSA 0002(393)
GARFIED & McCONE COUNTIES
SWAY BRACING DETAILS
Scale ~ 1: 30 except as shown
D457BRRRV009, DGN 18753